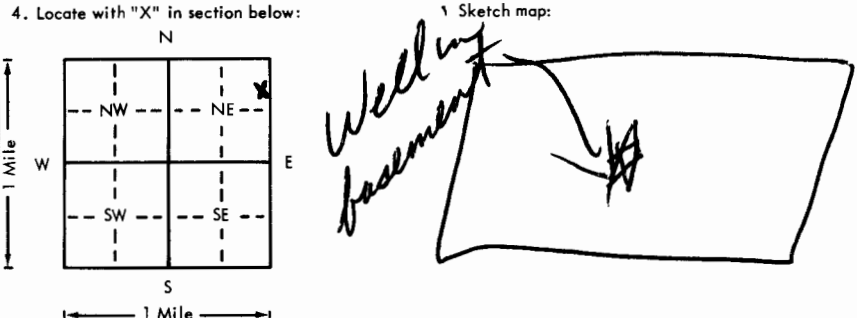


USE TYPEWRITER OR BALL
POINT PEN-PRESS FIRMLY,
PRINT CLEARLY.

WATER WELL RECORD
KSA 82a-1201-1215

Kansas Department of Health and
Environment-Division of Environment
(Water well Contractors)
Topeka, Kansas 66620

1. Location of well:	County: <u>Sedg.</u>	Fraction: <u>SE 1/4 NE 1/4 NE 1/4</u>	Section number: <u>6</u>	Township number: <u>T 28 S</u>	Range number: <u>R 4 E</u>	
2. Distance and direction from nearest town or city: <u>1 No. 1 W. 1/4 So Cheney Ks.</u>			3. Owner of well: <u>Steve Hampel</u> R.R. or street: <u>Box 305</u> City, state, zip code: <u>Garden Plain Ks 67050</u>	
4. Locate with "X" in section below: 			6. Bore hole dia. <u>11</u> in. Completion date <u>11-10-77</u> Well depth <u>70</u> ft.	
			7. ☒ Cable tool ☒ Rotary ☐ Driven ☐ Dug ☐ Hollow rod ☐ Jetted ☐ Bored ☐ Reverse rotary	
			8. Use: ☒ Domestic ☐ Public supply ☐ Industry ☐ Irrigation ☐ Air conditioning ☐ Stock ☐ Lawn ☐ Oil field water ☐ Other	
			9. Casing: Material <u>PVC</u> Height Above or below Threaded ☐ Welded ☒ Surface <u>17</u> in. RMP ☐ PVC ☒ Weight <u>231</u> lbs./ft. Dia. <u>5</u> in. to <u>70</u> ft. depth Wall Thickness: inches or Dia. <u>5</u> in. to <u>70</u> ft. depth gage No. <u>1214</u>	
5. Type and color of material			From	To	10. Screen: Manufacturer's name <u>MPI</u>	<u>Top Soil</u>			<u>0</u>	<u>4</u>	Type <u>PVC</u> Dia. <u>5</u> in.	<u>Red clay</u>			<u>3</u>	<u>25</u>	Slot gauge <u>1/16</u> Length <u>30</u> ft.	<u>gravel</u>			<u>25</u>	<u>27</u>	Set between <u>40</u> ft. and <u>70</u> ft.	<u>red shale</u>			<u>27</u>	<u>58</u>	Gravel pack? <u>yes</u> Size range of material <u>3/8</u>	<u>Blue-green shale</u>			<u>58</u>	<u>65</u>	11. Static water level: <u>22</u> ft. below land surface Date <u>11-10-77</u>	<u>Red shale</u>			<u>65</u>	<u>70</u>	12. Pumping level below land surfaces: <u>35</u> ft. after <u>1/2</u> hrs. pumping <u>15</u> g.p.m. <u> </u> ft. after <u> </u> hrs. pumping <u> </u> g.p.m. Estimated maximum yield <u>30</u> g.p.m.						13. Water sample submitted: <u> </u> mo./day/yr. Yes ☒ No ☐ Date <u> </u>						14. Well head completion: <u> </u> Pitless adapter <u>12</u> inches above grade						15. Well grouted? <u>yes</u> With: ☒ Neat cement ☐ Bentonite ☐ Concrete Depth: From <u>6</u> ft. to <u>16</u> ft.						16. Nearest source of possible contamination: ft. <u> </u> Direction <u>NE</u> Type <u> </u> Well disinfected upon completion? ☒ Yes ☐ No						17. Pump: ☒ Not installed Manufacturer's name <u> </u> Model number <u> </u> HP <u> </u> Volts <u> </u> Length of drop pipe <u> </u> ft. capacity <u> </u> g.p.m. Type: ☐ Submersible ☐ Turbine ☐ Jet ☐ Reciprocating ☐ Centrifugal ☐ Other						20. Water well contractor's certification: This well was drilled under my jurisdiction and this report is true to the best of my knowledge and belief. <u>Wagner's Drilling</u> 318 Business name <u>Chewish</u> License No. <u> </u> Address <u> </u> Signature <u> </u> Date <u>11/10/77</u> Authorized representative	18. Elevation:	19. Remarks:					Topography: ☐ Hill ☐ Slope ☒ Upland ☐ Valley					

Forward the white, blue and pink copies to the Department of Health and Environment

Form WWC-5