


1 LOCATION OF WATER WELL:		Fraction		Section Number		Township Number		Range Number	
County:	Sedawick	SE 1/4	SE 1/4	SE 1/4	12	T 28	S	R 4W	E(W)

1 LOCATION OF WATER WELL:	Fraction	Section Number	Township Number	Range Number
County: <u>Sedawick</u>	SE $\frac{1}{4}$ SE $\frac{1}{4}$ SE $\frac{1}{4}$	12	T 28 S	R 4W E(W)

Distance and direction from nearest town or city street address of well if located within city?
1 mile West of Garden Plain Rd. North side of McArthur Rd.
 2] WATER WELL OWNER: Rick May
 RR#, St. Address, Box # : R #1 Box 88
 City, State, ZIP Code : Cheney, Ks. 67025

Board of Agriculture, Division of Water Resources
 Application Number:

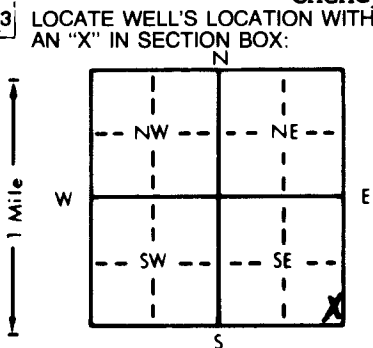

4 DEPTH OF COMPLETED WELL..... 40 ft. ELEVATION:
 Depth(s) Groundwater Encountered 1. 8 ft. 2. ft. 3. ft.
 WELL'S STATIC WATER LEVEL ... 8 ft. below land surface measured on mo/day/yr .. 12-29-89..
 Pump test data: Well water was ft. after hours pumping gpm
 Est. Yield gpm: Well water was ft. after hours pumping gpm
 Bore Hole Diameter. 11 in. to ft., and in. to ft.
 WELL WATER TO BE USED AS: 5 Public water supply 8 Air conditioning 11 Injection well
 1 Domestic 3 Feedlot 6 Oil field water supply 9 Dewatering 12 Other (Specify below)
 2 Irrigation 4 Industrial 7 Lawn and garden only 10 Monitoring well
 Was a chemical/bacteriological sample submitted to Department? Yes.....No.....X.....; If yes, mo/day/yr sample was sub-
 mitted Water Well Disinfected? Yes X No

5 TYPE OF BLANK CASING USED:		3 Wrought iron		8 Concrete tile		CASING JOINTS: Glued <u>X</u> . . . Clamped		
1 Steel	<u>3 RMP (SR)</u>	6 Asbestos-Cement	9 Other (specify below)			Welded		
2 PVC	4 ABS	7 Fiberglass	<u>Cer-Mac styrene SDR-26</u>			Threaded		
Blank casing diameter <u>5</u> in. to <u>11</u> ft., Dia in. to ft., Dia in. to ft.								
Casing height above land surface <u>1.2</u> in., weight <u>1.59</u> lbs./ft. Wall thickness or gauge No. <u>203</u>								
TYPE OF SCREEN OR PERFORATION MATERIAL:				7 PVC				
1 Steel	3 Stainless steel	5 Fiberglass	8 RMP (SR)	10 Asbestos-cement				
2 Brass	4 Galvanized steel	6 Concrete tile	<u>9 ABS</u>	11 Other (specify)				
SCREEN OR PERFORATION OPENINGS ARE:				12 None used (open hole)				
1 Continuous slot	3 Mill slot	5 Gauzed wrapped	8 Saw cut	11 None (open hole)				
2 Louvered shutter	4 Key punched	6 Wire wrapped	<u>9 Drilled holes</u>					
				7 Torch cut	10 Other (specify)			
SCREEN-PERFORATED INTERVALS:		From <u>11</u> ft. to <u>40</u> ft.,	From ft. to ft.,	From ft. to ft.,				
		From ft. to ft.,	From ft. to ft.,	From ft. to ft.,				
GRAVEL PACK INTERVALS:		From <u>10</u> ft. to <u>40</u> ft.,	From ft. to ft.,	From ft. to ft.,				
		From ft. to ft.,	From ft. to ft.,	From ft. to ft.,				

6 GROUT MATERIAL:		1 Neat cement	2 Cement grout	3 Bentonite	4 Other
Grout Intervals:		From 0 ft. to 10 ft.	From	ft. to	ft. to
What is the nearest source of possible contamination:				10 Livestock pens	14 Abandoned water well
1 Septic tank	4 Lateral lines	7 Pit privy	11 Fuel storage	15 Oil well/Gas well	
2 Sewer lines	5 Cess pool	8 Sewage lagoon	12 Fertilizer storage	16 Other (specify below)	
3 Watertight sewer lines	6 Seepage pit	9 Feedyard	13 Insecticide storage	None Apparent	
Direction from well?			How many feet?		

[illegible]

7. CONTRACTOR'S OR LANDOWNER'S CERTIFICATION: This water well was (1) constructed, (2) reconstructed, or (3) plugged under my jurisdiction and was completed on (mo/day/year) 12-29-89 and this record is true to the best of my knowledge and belief. Kansas Water Well Contractor's License No. 236 This Water Well Record was completed on (mo/day/yr) under the business name of Harp Well and Pump Service, Inc. by (signature) *Marvin Arnold*