


1 LOCATION OF WATER WELL: Fraction Section Number Township Number Range Number
 COUNTY: 094 STANTON SW 1/4 SW 1/4 SE 1/4 24 T 28 S R 40 W

Distance and direction from nearest town or city street address of well if located within city?
 FROM JOHNSON; APPX 1 MILE NORTH & 5 3/4 MILES EAST

2 WATER WELL OWNER: JOSSERAND CATTLE CO
 RR#, St. Address, Box #: PO BOX 390 Board of Agriculture, Division of Water Resources
 City, State, ZIP code: JOHNSON, KS 67855-0390 Application Number:

3 LOCATE WELL'S LOCATION WITH AN "X" IN SECTION BOX:

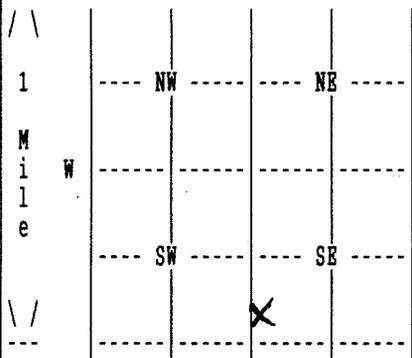

4 DEPTH OF COMPLETED WELL 540 ELEVATION: 0
 Depth(s) Groundwater Encountered 1. 0 ft. 2. 0 ft. 3. 0 ft.

WELL'S STATIC WATER LEVEL 0 ft. below land surface measured on mo/day/yr
 Pump test data: Well water was 0 ft. after 0 hours pumping 0 gpm

Estimated Yield 0 gpm: Well water was 0 ft. after 0 hours pumping 0 gpm

Bore Hole Diameter 14 3/4 in. to 540 ft., and in. to 0 ft.

WELL WATER TO BE USED AS: *DI DOMESTIC*

Was a chemical/bacteriological sample submitted to department? No;
 If yes, mo/day/yr sample was submitted Water well disinfected? Yes

5 TYPE OF BLANK CASING USED: 02 PVC CASING JOINTS: GLUED
 Blank casing diameter 5 in. to 540 ft., Dia in. to 0 ft., Dia in. to 0 ft.
 Casing height above land surface 12 in., weight 4 lbs/ft. Wall thickness or gauge No. .327
 TYPE OF SCREEN OR PERFORATION MATERIAL: 07 PVC
 SCREEN OR PERFORATION OPENINGS ARE: 03 MILL SLOT

SCREEN PERFORATED INTERVALS: From 300 ft. to 360 ft., From 460 ft. to 480 ft.
 From 400 ft. to 440 ft., From 500 ft. to 540 ft.
 GRAVEL PACK INTERVALS: From 25 ft. to 540 ft., From 0 ft. to 0 ft.
 From 0 ft. to 0 ft., From 0 ft. to 0 ft.

6 GROUT MATERIAL 03 BENTONITE
 Grout Intervals: From 5 ft. to 25 ft., From 0 ft. to 0 ft., From 0 ft. to 0 ft.
 What is the nearest source of possible contamination: NONE OBSERVED
 Direction from well? How many feet? 0

FROM	TO	LITHOLOGIC LOG	FROM	TO	PLUGGING INTERVALS
0	2	02 SILT			
2	5	04 SANDY CLAY			
5	14	07 FINE SAND			
14	90	04 SANDY CLAY			
90	94	07 FINE SAND 08 MEDIUM SAND			
94	118	04 SANDY CLAY 05 SAND			
118	124	07 FINE SAND 08 MEDIUM SAND			
124	130	04 SANDY CLAY			
130	140	05 SAND 01 CLAY			
140	160	04 SANDY CLAY 07 FINE SAND			

7 CONTRACTOR'S OR LANDOWNER'S CERTIFICATION: This water well was Constructed under my jurisdiction and was completed on (mo/day/year) 06/29/04 and this record is true to the best of my knowledge and belief. Kansas Water Well Contractor's License No. 145 This Water Well Record was completed on (mo/day/yr) 10/01/04 under the business name of HENKLE DRILLING & SUPPLY by (signature)

1 LOCATION OF WATER WELL: COUNTY: 094 STANTON	Fraction SW 1/4 SW 1/4 SE 1/4	Section Number 24	Township Number T 28 S	Range Number R 40 W
--	----------------------------------	----------------------	---------------------------	------------------------

2 WATER WELL OWNER: RR#, St. Address, Box # : City, State, ZIP code :	JOSSERAND CATTLE CO PO BOX 390 JOHNSON, KS 67855-0390	Board of Agriculture, Division of Water Resources Application Number:
---	---	--

FROM	TO	LITHOLOGIC LOG
160	173	07 FINE SAND 08 MEDIUM SAND
173	200	04 SANDY CLAY 20 LIMESTONE 07 FINE SAND
200	213	05 SAND
213	240	04 SANDY CLAY 20 LIMESTONE 07 FINE SAND
240	271	20 LIMESTONE 31 CALICHE 07 FINE SAND
271	286	05 SAND 13 FINE GRAVEL
286	345	04 SANDY CLAY
311	323	04 SANDY CLAY 20 LIMESTONE
323	380	04 SANDY CLAY
345	364	04 SANDY CLAY
364	396	01 CLAY
396	420	04 SANDY CLAY
420	436	05 SAND
436	460	01 CLAY
460	480	23 SANDSTONE
480	492	01 CLAY
492	500	19 SHALE
500	520	01 CLAY
520	529	19 SHALE
529	536	23 SANDSTONE
536	540	19 SHALE

7 CONTRACTOR'S OR LANDOWNER'S CERTIFICATION: This water well was Constructed under my jurisdiction and was completed on (mo/day/year) 06/29/04 and this record is true to the best of my knowledge and belief. Kansas Water Well Contractor's License No. 145 This Water Well Record was completed on (mo/day/yr) 10/01/04 under the business name of HENKLE DRILLING & SUPPLY by (signature)