USE TYPEWRITER OR BALL POINT PEN-PRESS FIRMLY, PRINT CLEARLY.

WATER WELL RECORD
KSA 82a-1201-1215

Kansas Department of Health and Environment-Division of Environment
(Water well Contractors)
Topeka, Kansas 66620

1. Location of well:	County	Fraction	Section number	Township number	Range number
	Stanton	NE 1/4 SW 1/4 NE 1/4	3	T 28 S	R 40 E/W

2. Distance and direction from nearest town or city: 3 east - 3 N 1/2 E of Johnson, Kans
Street address of well location if in city: 1/2 S

3. Owner of well: Kent Wenger
R.R. or street: RFD
City, state, zip code: Johnson Kans.

Locate with "X" in section below:

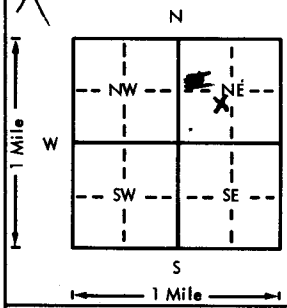

Sketch map:

6. Bore hole dia. 5 in. Completion date 11/79
Well depth 300' ft.

7. ___ Cable tool ✓ Rotary ___ Driven ___ Dug
___ Hollow rod ___ Jetted ___ Bored ___ Reverse rotary

8. Use: ✓ Domestic ___ Public supply ___ Industry
___ Irrigation ___ Air conditioning ___ Stock
___ Lawn ___ Oil field water ___ Other

9. Casing: Material ___ Height: Above or below
Threaded ___ Welded ___ Surface ___ in.
RMP ___ PVC 200' Weight ___ lbs./ft.
Dia. 5 in. to 10 ft. depth Wall Thickness: inches or
Dia. ___ in. to ___ ft. depth gage No. 262

5. Type and color of material	From	To
Clay	0'	40'
Fine sand to coarse	40'	300'

10. Screen: Manufacturer's name Jet Stream
Type PVC Dia. 5
Slot/gauze Slot Length 40'
Set between 260 ft. and 300 ft.
___ ft. and ___ ft.
Gravel pack? yes Size range of material #1

11. Static water level: mo./day/yr.
170 ft. below land surface Date 12/79

12. Pumping level below land surfaces:
180' ft. after 12 hrs. pumping 15 g.p.m.
___ ft. after ___ hrs. pumping ___ g.p.m.
Estimated maximum yield ___ g.p.m.

13. Water sample submitted: mo./day/yr.
___ Yes ✓ No Date ___

14. Well head completion:
✓ Pitless adapter ___ Inches above grade

15. Well grouted? ___
With: ___ Neat cement ___ Bentonite ✓ Concrete
Depth: From 5 ft. to 20 ft.

16. Nearest source of possible contamination:
ft. 100 Direction E Type Sewer
Well disinfected upon completion? ✓ Yes ___ No

17. Pump: ___ Not installed
Manufacturer's name Gould
Model number 10EJ15 HP 1½ Volts 230
Length of drop pipe 210' ft. capacity 12 g.p.m.
Type:
✓ Submersible ___ Turbine
___ Jet ___ Reciprocating
___ Centrifugal ___ Other

(Use a second sheet if needed)

18. Elevation:

Topography:
___ Hill
___ Slope
___ Upland
___ Valley

19. Remarks:

20. Water well contractor's certification:
This well was drilled under my jurisdiction and this report is true to the best of my knowledge and belief.
Jim Smith Pump Service 160
Business name License No.
Address Johnson Kans. 67855
Signed James Ray Smith Date 12/79
Authorized representative

28 T 40 R 3 Sec NE 1/4 SW 1/4 NE 1/4

Forward the white, blue and pink copies to the Department of Health and Environment

Form WWC-5