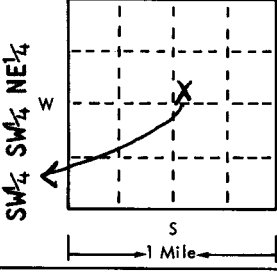
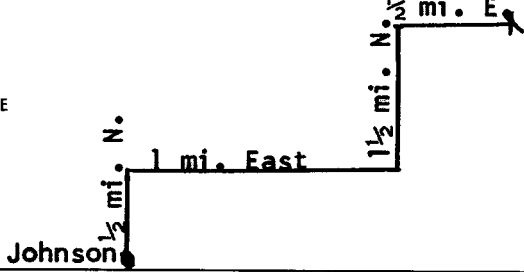


USE TYPEWRITER OR BALL
POINT PEN-PRESS FIRMLY,
PRINT CLEARLY.

WATER WELL RECORD
KSA 82a-1201-1215

T R EW sec 1/4 1/4 1/4 No.
Kansas State Dept. Of Health
(Water Well Contractors)
Forbes-Bldg. 740
Topeka, Kansas 66620

1 Location of well:	County Stanton	Township name	Fraction SW$\frac{1}{4}$, SW$\frac{1}{4}$, NE$\frac{1}{4}$	Section number 19	Town number T28S	Range number R40W			
Distance and direction from nearest town or city: $\frac{1}{2}$ mi. N. & 1 mi. E. of Johnson				3 Owner of well: XXXXXXXXXXXXXX Address: LaVere Walker Johnson, Kansas 67855					
Locate with "X" in section below: 				Sketch map: 			4 Well depth: 400 ft. Date of completion _____ Well diameter 26 in.		
2 Type and color of material				5 <input type="checkbox"/> Cable tool <input type="checkbox"/> Rotary <input type="checkbox"/> Driven <input type="checkbox"/> Dug <input type="checkbox"/> Hollow rod <input type="checkbox"/> Jetted <input type="checkbox"/> Bored <input checked="" type="checkbox"/> Reverse rotary					
				6 Use: <input type="checkbox"/> Domestic <input type="checkbox"/> Public supply <input type="checkbox"/> Industry <input checked="" type="checkbox"/> Irrigation <input type="checkbox"/> Air conditioning <input type="checkbox"/> Commercial <input type="checkbox"/> Test well <input type="checkbox"/> _____					
				7 Casing: Material Steel Height: above/below _____ Threaded <input type="checkbox"/> Welded <input checked="" type="checkbox"/> Surface 12 in. Diam. 16 in. Weight 34.5 lbs./ft. 16 in. to 400 ft. depth Drive shoe? <input type="checkbox"/> Yes <input checked="" type="checkbox"/> No _____ in. to _____ ft. depth					
				8 Screen: Manufacturer Johnson Type Galvanized Dia. 16 in. Slot/groove 100x100 Length 40 ft. Set between 320 ft. and 360 ft. Fittings: *See remarks Gravel pack <input checked="" type="checkbox"/> Yes <input type="checkbox"/> No Size range of material $\frac{1}{2}$ down					
				9 Static water level: 167 ft. below land surface Date 4-3-76					
(use a second sheet if needed)				10 Pumping level below land surfaces: 210 ft. after 1 hrs. pumping 800 g.p.m. _____ ft. after _____ hrs. pumping _____ g.p.m. Estimated maximum yield 1800 g.p.m.					
				11 Water sample submitted: <input type="checkbox"/> Yes <input checked="" type="checkbox"/> No Date _____					
				12 Well head completion: 12 in. <input type="checkbox"/> Pitless adapter <input checked="" type="checkbox"/> Inches above grade					
				13 Well grouted? <input checked="" type="checkbox"/> Yes <input type="checkbox"/> No <input checked="" type="checkbox"/> Neat cement <input checked="" type="checkbox"/> Bentonite <input type="checkbox"/> _____ Depth: From 0 ft. to 10 ft.					
				14 Nearest source of possible contamination: ft. _____ Direction None in field Well disinfected upon completion? <input type="checkbox"/> Yes <input checked="" type="checkbox"/> No					
16 Remarks: elevation Topography: <input type="checkbox"/> Hill <input checked="" type="checkbox"/> Slope <input type="checkbox"/> Upland <input type="checkbox"/> Valley				15 Pump: <input type="checkbox"/> Not installed Manufacturer's name Goulds Model number 121 HP 200 Volts _____ Length of drop pipe 300 ft. capacity 1800 g.m.p. Type: <input type="checkbox"/> Submersible <input checked="" type="checkbox"/> Turbine <input type="checkbox"/> Jet <input type="checkbox"/> Reciprocating <input type="checkbox"/> Centrifugal <input type="checkbox"/> Other					
				17 Water well contractor's certification: This well was drilled under my jurisdiction and this report is true to the best of my knowledge and belief. K. I. Drilling Co., Inc. 263 Business name _____ License No. _____ Address Box 669, Ulysses, Kn. 67880 Signed M. Joyce Bank Date 4-20-76 Authorized representative					
				18 _____					
				19 _____					
				20 _____					