

USE TYPEWRITER OR BALL POINT PEN-PRESS FIRMLY, PRINT CLEARLY.

T R EW sec 1/4 1/4 1/4 No.


WATER WELL RECORD
KSA 82a-1201-1215

Kansas State Dept. Of Health
(Water Well Contractors)
Forbes-Bldg. 740
Topeka, Kansas 66620

1 Location of well:	County Stanton	Township name Big Big Bow	Fraction SW¹/₄ SW¹/₄ SW¹/₄	Section number 26	Town number 28S	Range number 40W
---------------------	--------------------------	--	--	-----------------------------	---------------------------	----------------------------

Distance and direction from nearest town or city:
a7 miles west of Ulysses, Kansas
Street address of well location if in city:

3 Owner of well:
Ivan Josserand Johnson, Kansas
Address:

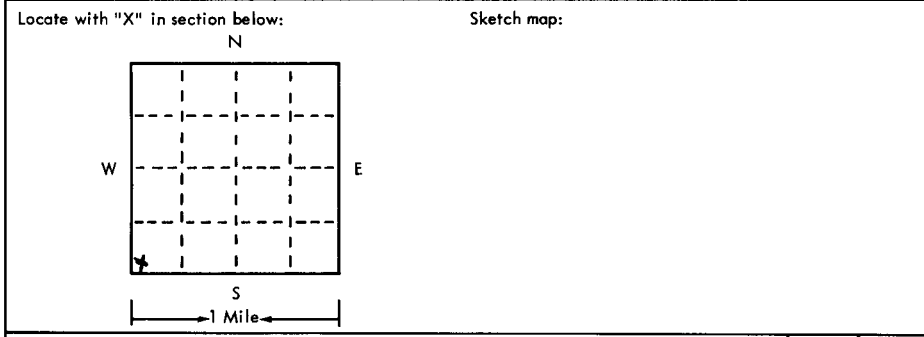

4 Well depth: **450** ft. Date of completion **7/31/75**
Well diameter **27** in.

5 Cable tool Rotary Driven Dug
 Hollow rod Jetted Bored Reverse rotary

6 Use: Domestic Public supply Industry
 Irrigation Air conditioning Commercial
 Test well

7 Casing: Material **stl.** Height: **above**/below
Threaded Welded Surface **12** in.
Diam. **18"** Weight **47.3** lbs./ft. **1**
0 in. to **250** ft. depth! Drive shoe? Yes No
— in. to — ft. depth!

2	Type and color of material	From	To
	Surface	0	2
	Sandy clay	2	44
	Medium to coarse sadn	44	67
	Sandy lcy w/hard lime shells	67	90
	Coarse sand (tight)	90	105
	Brown and gray clay w/small sand strips	105	150
	Brown clay (tight)	150	224
	Coarse sand	224	242
	Embedded sand & clay	242	251
	Medium to coarse sand w/clay breakers	251	270
	Fine to Medium sand w/clay breakers	270	285
	Coarse sand	285	298
	Embedded sand and clay	298	307
	Medium to coarse sand	307	315
	Fine to medium sand w/small clay breakers	315	337
	Coarse sand	337	378
	Sandy clay w/small sand strips	378	395
	Coarse sand	395	450
	Yellow chlak and blue shale	450	465

(use a second sheet if needed)

8 Screen: **Johnson Screen**
Manufacturer: **Lakewood Perf.**
Type **stl. & gal.** Dia. **18"**
Slot/auze **3/16** Length **2"** slot
Set **from 250 ft. to 410 ft.**
— fittings: screen: **410 to 450**
Gravel pack: Yes No Size range of material **1x5/8**

9 Static water level:
187 ft. below land surface Date **5/26/75**

10 Pumping level below land surfaces:
210 ft. after **16** hrs. pumping **1500** g.p.m.
207 ft. after **16** hrs. pumping **1300** g.p.m.
Estimated maximum yield **4000** g.p.m.

11 Water sample submitted:
 Yes No Date _____

12 Well head completion:
 Pitless adapter **12** inches above grade

13 Well grouted? Yes No
 Neat cement Bentonite _____
Depth: From **0** ft. to **10** ft.

14 Nearest source of possible contamination:
ft. _____ Direction _____ Type **NA**
Well disinfected upon completion? Yes No

15 Pump: Not installed
Manufacturer's name _____
Model number _____ HP _____ Volts _____
Length of drop pipe _____ ft. capacity _____ g.m.p.
Type:
 Submersible Turbine
 Jet Reciprocating
 Centrifugal Other

16 Remarks: elevation
Lakewood perforation set from 250 to 410 ft.
Johnson Screen set from 410 to 450 ft.

Topography:
 Hill
 Slope
 Upland
 Valley

17 Water well contractor's certification:
This well was drilled under my jurisdiction and this report is true to the best of my knowledge and belief.
Houch Bros Drly Co. 164
Business name _____ License No. _____
Address **Box 487, Ulysses, Ka**
Signed **M. Beard** Date **8/15/75**
Authorized representative