


1 LOCATION OF WATER WELL: County: **Stanton** Fraction: **NE 1/4 SW 1/4 SE 1/4** Section Number: **33** Township Number: **T 28 S** Range Number: **R 40 EW**

Distance and direction from nearest town or city street address of well if located within city? **From Johnson Kansas go 3mi East 1/2mi South West in to location.**

2 WATER WELL OWNER: **Western Feedyards, Inc.** Board of Agriculture, Division of Water Resources
 RR#, St. Address, Box #: **Route #1 Box 8** Application Number: **36,373**
 City, State, ZIP Code: **Johnson, Kansas 67855**

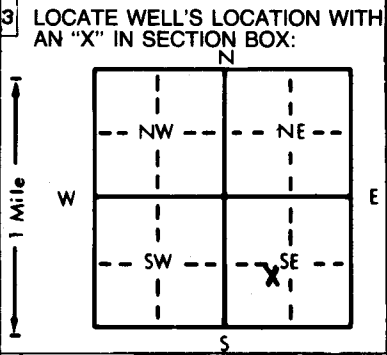

4 DEPTH OF COMPLETED WELL: **450** ft. ELEVATION: _____
 Depth(s) Groundwater Encountered 1. **222** ft. 2. _____ ft. 3. _____ ft.
 WELL'S STATIC WATER LEVEL **228** ft. below land surface measured on mo/day/yr **7/5/83**
 Pump test data: Well water was _____ ft. after _____ hours pumping _____ gpm
 Est. Yield **150** gpm: Well water was _____ ft. after _____ hours pumping _____ gpm
 Bore Hole Diameter: **15** in. to _____ ft., and _____ in. to _____ ft.
 WELL WATER TO BE USED AS:
 5 Public water supply 8 Air conditioning 11 Injection well
 1 Domestic 3 Feedlot 6 Oil field water supply 9 Dewatering 12 Other (Specify below)
 2 Irrigation 4 Industrial 7 Lawn and garden only 10 Observation well
 Was a chemical/bacteriological sample submitted to Department? Yes _____ No _____; If yes, mo/day/yr sample was submitted _____
 Water Well Disinfected? Yes _____ No _____

5 TYPE OF BLANK CASING USED:
 1 Steel 3 RMP (SR) 5 Wrought iron 8 Concrete tile CASING JOINTS: Glued _____ Clamped _____
 2 PVC 4 ABS 6 Asbestos-Cement 9 Other (specify below) Welded _____
 7 Fiberglass Threaded _____
 Blank casing diameter **8 5/8 steel to 310** ft., Dia _____ in. to _____ ft., Dia _____ in. to _____ ft.
 Casing height above land surface: **2'** in., weight **plain 22.28 per foot** Wall thickness or gauge No. **219**
 TYPE OF SCREEN OR PERFORATION MATERIAL: **screen 16.91 per foot**
 1 Steel 3 Stainless steel 5 Fiberglass 8 RMP (SR) 11 Other (specify) _____
 2 Brass 4 Galvanized steel 6 Concrete tile 9 ABS 12 None used (open hole)
 SCREEN OR PERFORATION OPENINGS ARE:
 1 Continuous slot 3 Mill slot 5 Gauzed wrapped 8 Saw cut 11 None (open hole)
 2 Louvered shutter 4 Key punched 6 Wire wrapped 9 Drilled holes
 7 Torch cut 10 Other (specify) **Doerr Screen**
 SCREEN-PERFORATED INTERVALS: From **1/16 265** ft. to **345** ft., From _____ ft. to _____ ft.
 From **3/32 385** ft. to **445** ft., From _____ ft. to _____ ft.
 GRAVEL PACK INTERVALS: From **0** ft. to **20** ft., From _____ ft. to _____ ft.
 From _____ ft. to _____ ft., From _____ ft. to _____ ft.

6 GROUT MATERIAL: 1 Neat cement 2 Cement grout 3 Bentonite 4 Other _____
 Grout Intervals: From **0** ft. to **20** ft., From _____ ft. to _____ ft., From _____ ft. to _____ ft.
 What is the nearest source of possible contamination:
 1 Septic tank 4 Lateral lines 7 Pit privy 10 Livestock pens 14 Abandoned water well
 2 Sewer lines 5 Cess pool 8 Sewage lagoon 11 Fuel storage 15 Oil well/Gas well
 3 Watertight sewer lines 6 Seepage pit 9 Feedyard 12 Fertilizer storage 16 Other (specify below)
 13 Insecticide storage _____
 Direction from well? Northeast How many feet? **100'**

FROM	TO	LITHOLOGIC LOG	FROM	TO	LITHOLOGIC LOG
0	2	01 surface			
2	75	04 sandy clay			
75	246	07 fine sand			
246	352	05 medium to large sand			
352	378	04 sandy clay			
378	450	05 medium to large sand			

7 CONTRACTOR'S OR LANDOWNER'S CERTIFICATION: This water well was (1) constructed, (2) reconstructed, or (3) plugged under my jurisdiction and was completed on (mo/day/year) **July 5-7, 1983** and this record is true to the best of my knowledge and belief, Kansas Water Well Contractor's License No. **118** This Water Well Record was completed on (mo/day/yr) **July 28, 1983** under the business name of **Carlile Water Well Service Inc.** by (signature) **Edward E. Means**
 INSTRUCTIONS: Use typewriter or ball point pen, PLEASE PRESS FIRMLY and PRINT clearly. Please fill in blanks, underline or circle the correct answers. Send top three copies to Kansas Department of Health and Environment, Division of Environment, Environmental Geology Section, Topeka, KS 66620. Send one to WATER WELL OWNER and retain one for your records.