


1 LOCATION OF WATER WELL: Fraction NW 1/4 NE 1/4 NE 1/4 Section Number 1 Township Number T 28 S Range Number R 41 EW
 County: Stanton

Distance and direction from nearest town or city street address of well if located within city?
 4 miles north of Johnson, Kansas

2 WATER WELL OWNER: Cross & Nicholas
 RR#, St. Address, Box #: RFD #1
 City, State, ZIP Code: Jonnson, Kansas 67880 67855
 Board of Agriculture, Division of Water Resources
 Application Number: 31.930

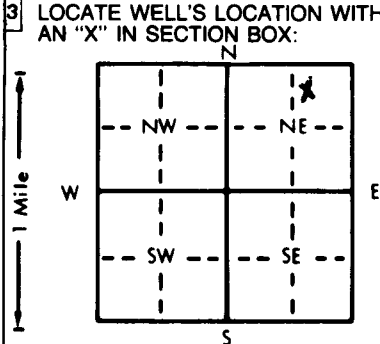

4 DEPTH OF COMPLETED WELL: 589 ft. ELEVATION: SLOPE
 Depth(s) Groundwater Encountered 234 ft. 2. ft. 3. ft.
 WELL'S STATIC WATER LEVEL 234 ft. below land surface measured on mo/day/yr 1/9/98
 Pump test data: Well water was ft. after hours pumping gpm
 Est. Yield gpm: Well water was ft. after hours pumping gpm
 Bore Hole Diameter 24 in. to 589 ft., and in. to ft.
 WELL WATER TO BE USED AS:
 5 Public water supply 8 Air conditioning 11 Injection well
 1 Domestic 3 Feedlot 6 Oil field water supply 9 Dewatering 12 Other (Specify below)
 2 Irrigation 4 Industrial 7 Lawn and garden only 10 Monitoring well
 Was a chemical/bacteriological sample submitted to Department? Yes No X; If yes, mo/day/yr sample was submitted
 Water Well Disinfected? Yes X No

5 TYPE OF BLANK CASING USED:
 1 Steel 3 RMP (SR) 5 Wrought iron 8 Concrete tile CASING JOINTS: Glued Clamped
 2 PVC 4 ABS 6 Asbestos-Cement 9 Other (specify below) Welded X
 7 Fiberglass Threaded
 Blank casing diameter .16 in. to 289 ft., Dia in. to ft., Dia in. to ft.
 Casing height above land surface 17 in., weight 36.91 lbs./ft. Wall thickness or gauge No. 2.19
 TYPE OF SCREEN OR PERFORATION MATERIAL:
 1 Steel 3 Stainless steel 5 Fiberglass 8 RMP (SR) 10 Asbestos-cement
 2 Brass 4 Galvanized steel 6 Concrete tile 9 ABS 11 Other (specify)
 12 None used (open hole)
 SCREEN OR PERFORATION OPENINGS ARE:
 1 Continuous slot 2 Mill slot 5 Gauzed wrapped 8 Saw cut 11 None (open hole)
 2 Louvered shutter 4 Key punched 6 Wire wrapped 9 Drilled holes
 7 Torch cut 10 Other (specify)
 SCREEN-PERFORATED INTERVALS: From 289 ft. to 589 ft., From ft. to ft.
 GRAVEL PACK INTERVALS: From 20 ft. to 589 ft., From ft. to ft.

6 GROUT MATERIAL: 1 Neat cement 2 Cement grout 3 Bentonite 4 Other
 Grout Intervals: From 0 ft. to 20 ft., From ft. to ft., From ft. to ft.
 What is the nearest source of possible contamination:
 1 Septic tank 4 Lateral lines 7 Pit privy 10 Livestock pens 14 Abandoned water well
 2 Sewer lines 5 Cess pool 8 Sewage lagoon 11 Fuel storage 15 Oil well/Gas well
 3 Watertight sewer lines 6 Seepage pit 9 Feedyard 12 Fertilizer storage 16 Other (specify below)
 13 Insecticide storage Farm site
 Direction from well? South east How many feet? 700

FROM	TO	LITHOLOGIC LOG	FROM	TO	PLUGGING INTERVALS
0	2	Surface	485	490	Shale
2	16	Fine to medium sand	490	498	Sandstone
16	40	Medium and w/clay breakers	498	565	Brown sahle and sandstone
40	55	Fine sand	565	568	Rock
55	102	Brown clay	568	590	Brown shale and sandstone
102	185	Fine to coarse sand			
185	230	Sandy clay w/fine sand			
230	345	Sedium sand some fine w/small clay breakers			
345	365	Sandy clay w/fine sand			
365	372	Sandrock good			
372	395	Yellow chalk, dakota sandstone			
395	412	Blue shale			
412	450	Blue shale & sandstone			
450	460	Sandstone			
460	485	Brown & gray shale /sandstone			

7 CONTRACTOR'S OR LANDOWNER'S CERTIFICATION: This water well was (1) constructed, (2) reconstructed, or (3) plugged under my jurisdiction and was completed on (mo/day/year) 1/8/98 and this record is true to the best of my knowledge and belief. Kansas Water Well Contractor's License No. 164 This Water Well Record was completed on (mo/day/yr) 5/5/98 under the business name of Houck Bros. Drilling Co. by (signature) M. Beard

INSTRUCTIONS: Use typewriter or ball point pen. PLEASE PRESS FIRMLY and PRINT clearly. Please fill in blanks, underline or circle the correct answers. Send top three copies to Kansas Department of Health and Environment, Bureau of Water, Topeka, Kansas 66620-0001. Telephone: 913-296-5545. Send one to WATER WELL OWNER and retain one for your records.