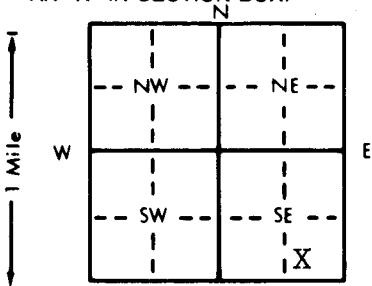


1 LOCATION OF WATER WELL: County: **Stanton** Fraction: **SW 1/4 SE 1/4 SE 1/4** Section Number: **5** Township Number: **T 28 S** Range Number: **R 41 E/W**

Distance and direction from nearest town or city street address of well if located within city?
From NW corner of Johnson - 4 Miles North, 3 Miles West, 680 Ft. West & 90 Ft. North

2 WATER WELL OWNER: **Triple L Farms by Charles Lawhead**
 RR#, St. Address, Box #: **201 N. Knox St.** Board of Agriculture, Division of Water Resources
 City, State, ZIP Code: **Johnson, Kansas 67855** Application Number: **9,520 & 10,502**

3 LOCATE WELL'S LOCATION WITH AN "X" IN SECTION BOX:

 4 DEPTH OF COMPLETED WELL: **340** ft. ELEVATION:
 Depth(s) Groundwater Encountered 1. ft. 2. ft. 3. ft.
 WELL'S STATIC WATER LEVEL: **261** ft. below land surface measured on mo/day/yr **6-4-94**
 Pump test data: Well water was ft. after hours pumping gpm
 Est. Yield gpm: Well water was ft. after hours pumping gpm
 Bore Hole Diameter: **30** in. to **340** ft., and in. to ft.
 WELL WATER TO BE USED AS:
 1 Domestic 3 Feedlot 6 Oil field water supply 9 Dewatering 11 Injection well
 2 Irrigation 4 Industrial 7 Lawn and garden only 10 Monitoring well 12 Other (Specify below)
 Was a chemical/bacteriological sample submitted to Department? Yes.....No.....**X**.....; If yes, mo/day/yr sample was submitted
 Water Well Disinfected? Yes No **X**

5 TYPE OF BLANK CASING USED:
 1 Steel 3 RMP (SR) 5 Wrought iron 8 Concrete tile CASING JOINTS: Glued Clamped
 2 PVC 4 ABS 6 Asbestos-Cement 9 Other (specify below) Welded **X**
 7 Fiberglass Threaded.....
 Blank casing diameter **16** in. to **280** ft., Dia in. to ft., Dia in. to ft.
 Casing height above land surface: **12** in., weight **42.05** lbs./ft. Wall thickness or gauge No. **250**
 TYPE OF SCREEN OR PERFORATION MATERIAL:
 1 Steel 3 Stainless steel 5 Fiberglass 8 RMP (SR) 10 Asbestos-cement
 2 Brass 4 Galvanized steel 6 Concrete tile 9 ABS 11 Other (specify)
 12 None used (open hole)
 SCREEN OR PERFORATION OPENINGS ARE:
 1 Continuous slot 2 Louvered shutter 3 Mill slot 4 Key punched 5 Gauzed wrapped 6 Wire wrapped 8 Saw cut 11 None (open hole)
 7 Torch cut 10 Other (specify)
 SCREEN-PERFORATED INTERVALS: From **280** ft. to **340** ft., From ft. to ft.
 GRAVEL PACK INTERVALS: From **20** ft. to **340** ft., From ft. to ft.

6 GROUT MATERIAL: 1 Neat cement 2 Cement grout 3 Bentonite 4 Other
 Grout Intervals: From **0** ft. to **20** ft., From ft. to ft., From ft. to ft.
 What is the nearest source of possible contamination:
 1 Septic tank 4 Lateral lines 7 Pit privy 11 Fuel storage 14 Abandoned water well
 2 Sewer lines 5 Cess pool 8 Sewage lagoon 12 Fertilizer storage 15 Oil well/Gas well
 3 Watertight sewer lines 6 Seepage pit 9 Feedyard 13 Insecticide storage 16 Other (specify below)
 Direction from well? **South** How many feet? **170 Ft.**

FROM	TO	LITHOLOGIC LOG	FROM	TO	PLUGGING INTERVALS
		See attached log			

7 CONTRACTOR'S OR LANDOWNER'S CERTIFICATION: This water well was **(1)** constructed, (2) reconstructed, or (3) plugged under my jurisdiction and was completed on (mo/day/year) **6-6-94** and this record is true to the best of my knowledge and belief. Kansas Water Well Contractor's License No. **208**. This Water Well Record was completed on (mo/day/yr) **6-30-94** under the business name of **Minter-Wilson Drilling Co., Inc.** by (signature) *Nora Keller*

INSTRUCTIONS: Use typewriter or ball point pen. PLEASE PRESS FIRMLY and PRINT clearly. Please fill in blanks, underline or circle the correct answers. Send top three copies to Kansas Department of Health and Environment, Bureau of Water, Topeka, Kansas 66620-0001. Telephone: 913-296-5545. Send one to WATER WELL OWNER and retain one for your records.

The
Professionals

MINTER-WILSON DRILLING CO.

INCORPORATED

Irrigation
and Domestic
Water Systems
Complete Installation
and Repairing

Phone 276-8269 • P.O. Box A • GARDEN CITY, KANSAS 67846

Charles Lawhead
Stanton County
4-18-94

Location: SE $\frac{1}{4}$ 5-28-41 - From Johnson 4 Miles North,
3 Miles West- 697 Ft. West & 189 Ft. North
of old well

Static Water Level - 259'

Test #1

- 0' to 1' - Top soil
- 01 1' to 10' - Brown clay
- 04 10' to 26' - Brown sandy clay
- 07 26' to 83' - Fine to medium sand - loose
- 01 83' to 108' - Brown clay
- 108' to 157' - Fine to medium sand & gravel-10% clay
- 157' to 170' - Fine to medium sand & gravel -
10% clay - tight
- 17 170' to 178' - Fine to medium sand & gravel-10% clay
- 01 178' to 187' - Brown clay
- 17 187' to 201' - Fine to medium sand & gravel
- 01 201' to 210' - Brown clay
- 17 210' to 254' - Fine to medium sand & gravel
- 01 254' to 264' - Brown clay
- 17 264' to 298' - Fine to medium sand & gravel-10% clay
- 04 298' to 304' - Brown sandy clay
- 17 304' to 327' - Fine to medium sand & gravel-10% clay
- 01 327' to 352' - Yellow clay - hard pull down
- 19 352' to 380' - Shale