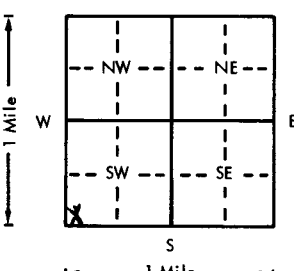
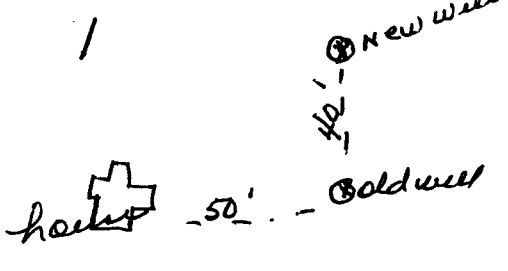


USE TYPEWRITER OR BALL  
POINT PEN-PRESS FIRMLY,  
PRINT CLEARLY.

WATER WELL RECORD  
KSA 82a-1201-1215

Kansas Department of Health and  
Environment-Division of Environment  
(Water well Contractors)  
Topeka, Kansas 66620

1. Location of well:	County <b>Stanton</b>	Fraction <b>SW 1/4 SW 1/4 SW 1/4</b>	Section number <b>29</b>	Township number <b>T 28 S</b>	Range number <b>R 41 E/W</b>
2. Distance and direction from nearest town or city: <b>3.8 miles</b> Street address of well location if in city: <b>west of Johnson, Ks.</b>		3. Owner of well: <b>Marvin McKinney</b> R.R. or street: <b>Johnson, Kansas 67855</b> City, state, zip code:			
4. Locate with "X" in section below: 		Sketch map: 		6. Bore hole dia. <u>9 1/2</u> in. Completion date <u>12-7-76</u> Well depth <u>300</u> ft.	
5. Type and color of material		From	To	7. <input checked="" type="checkbox"/> Cable tool <input checked="" type="checkbox"/> Rotary <input type="checkbox"/> Driven <input type="checkbox"/> Dug <input type="checkbox"/> Hollow rod <input type="checkbox"/> Jetted <input type="checkbox"/> Bored <input type="checkbox"/> Reverse rotary	
Surface		0	2	8. Use: <input checked="" type="checkbox"/> Domestic <input type="checkbox"/> Public supply <input type="checkbox"/> Industry <input type="checkbox"/> Irrigation <input type="checkbox"/> Air conditioning <input type="checkbox"/> Stock <input type="checkbox"/> Lawn <input type="checkbox"/> Oil field water <input type="checkbox"/> Other	
Fine to medium sand		2	56	9. Casing: Material <u>styrene</u> Height <u>12</u> ft. Above or below Threaded <input type="checkbox"/> Welded <input checked="" type="checkbox"/> Surface <u>12</u> in. RMP <input type="checkbox"/> PVC <input type="checkbox"/> Weight <u>12</u> lbs./ft. Dia. <u>5</u> in. to <u>260</u> ft. depth Wall Thickness: inches or Dia. <u>5</u> in. to <u>260</u> ft. depth gage No. <u>320</u>	
Sandy clay		56	93	10. Screen: Manufacturer's name <u>Sunflower</u> Type <u>styrene</u> Dia. <u>1 1/2</u> 5" Slot/gauze <u>1/16</u> Length <u>40</u> ft. Set between <u>260</u> ft. and <u>300</u> ft. ft. and <u>300</u> ft. Gravel pack? <input checked="" type="checkbox"/> Size range of material <u>No. 1</u>	
Fine sand w/clay strips		93	127	11. Static water level: <u>230</u> ft. below land surface Date <u>12-16-76</u> me./day/yr.	
Fine sand w/clay strips		127	300	12. Pumping level below land surfaces: <u>235</u> ft. after <u>6</u> hrs. pumping <u>13</u> g.p.m. ft. after <u>6</u> hrs. pumping <u>13</u> g.p.m. Estimated maximum yield <u>20</u> g.p.m.	
				13. Water sample submitted: <u>me./day/yr.</u> <input type="checkbox"/> Yes <input checked="" type="checkbox"/> No Date <u>12-16-76</u>	
				14. Well head completion: <input checked="" type="checkbox"/> Pitless adapter <u>12</u> inches above grade	
				15. Well grouted? <input checked="" type="checkbox"/> With: <input type="checkbox"/> Neat cement <input checked="" type="checkbox"/> Bentonite <input type="checkbox"/> Concrete Depth: From <u>0</u> ft. to <u>12</u> ft.	
				16. Nearest source of possible contamination: <u>MA</u> ft. <u>50</u> Direction <u>East</u> Type <u>Cow lot</u> Well disinfected upon completion? <input checked="" type="checkbox"/> Yes <input type="checkbox"/> No	
				17. Pump: <input checked="" type="checkbox"/> Not installed Manufacturer's name _____ Model number _____ HP _____ Volts _____ Length of drop pipe _____ ft. capacity _____ g.p.m. Type: <input type="checkbox"/> Submersible <input type="checkbox"/> Turbine <input type="checkbox"/> Jet <input type="checkbox"/> Reciprocating <input type="checkbox"/> Centrifugal <input type="checkbox"/> Other	
18. Elevation:		19. Remarks:		20. Water well contractor's certification: This well was drilled under my jurisdiction and this report is true to the best of my knowledge and belief. <b>Houck Bros. Drlg. Co. 164</b> Business name License No. Address <b>Box 487, Ulysses, Ks.</b> Signed <b>M. Beard</b> Date <b>12/30/76</b> Authorized representative	