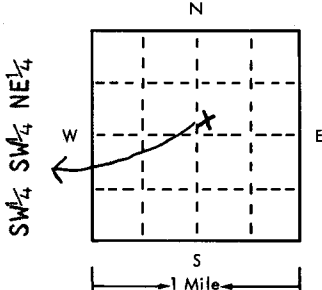
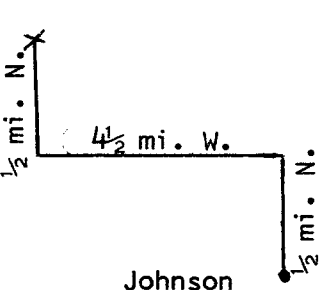


USE TYPEWRITER OR BALL  
POINT PEN-PRESS FIRMLY,  
PRINT CLEARLY.

WATER WELL RECORD  
KSA 82a-1201-1215

T R EW sec 1/4 1/4 1/4 No.

Kansas State Dept. Of Health  
(Water Well Contractors)  
Forbes-Bldg. 740  
Topeka, Kansas 66620

1 Location of well:	County <b>Stanton</b>	Township name	Fraction <b>SW<sup>1</sup>/<sub>4</sub>SW<sup>1</sup>/<sub>4</sub>NE<sup>1</sup>/<sub>4</sub></b>	Section number <b>30</b>	Town number <b>T28S</b>	Range number <b>R41W</b>
Distance and direction from nearest town or city: <b>1/2 mi. N., 4 1/2 mi. W., 1/2 mi. N. of Johnson</b> Street address of well location if in city:				3 Owner of well: <b>Marvin McKinney</b> Address: <b>P.O. Box 356 Johnson, Kansas 67855</b>		
Locate with "X" in section below: 		Sketch map: 		4 Well depth: <b>334</b> ft. Date of completion <b>4-2-75</b> Well diameter <b>26</b> in.		
2 Type and color of material		From To		5 <input type="checkbox"/> Cable tool <input type="checkbox"/> Rotary <input type="checkbox"/> Driven <input type="checkbox"/> Dug <input type="checkbox"/> Hollow rod <input type="checkbox"/> Jetted <input type="checkbox"/> Bored <input checked="" type="checkbox"/> Reverse rotary		
				6 Use: <input type="checkbox"/> Domestic <input type="checkbox"/> Public supply <input type="checkbox"/> Industry <input checked="" type="checkbox"/> Irrigation <input type="checkbox"/> Air conditioning <input type="checkbox"/> Commercial <input type="checkbox"/> Test well <input type="checkbox"/>		
				7 Casing: Material <b>Steel</b> Height: above/below Threaded <input type="checkbox"/> Welded <input checked="" type="checkbox"/> Surface <b>12</b> in. Diam. <b>16</b> in. to <b>335</b> ft. depth Drive shoe? <input type="checkbox"/> Yes <input checked="" type="checkbox"/> No Weight <b>34 1/2</b> lbs./ft.		
				8 Screen: Manufacturer <b>Johnson</b> Type <b>Galvanized</b> Dia. <b>16"</b> Slot/gauze <b>100</b> Length <b>20'</b> Set between <b>280</b> ft. and <b>300</b> ft. <b>50 lb. per Ft.</b> Fittings: <b>*See Remarks</b> Gravel pack <input checked="" type="checkbox"/> Yes <input type="checkbox"/> No Size range of material <b>1/2 down</b>		
				9 Static water level: <b>180</b> ft. below land surface Date <b>4-3-75</b>		
Surface & Brown Clay		0 163		10 Pumping level below land surfaces: <b>240</b> ft. after <b>8</b> hrs. pumping <b>950</b> g.p.m. ____ ft. after ____ hrs. pumping ____ g.p.m. Estimated maximum yield <b>1000</b> g.p.m.		
Medium Sand		163 178		11 Water sample submitted: <input type="checkbox"/> Yes <input checked="" type="checkbox"/> No Date ____		
Brown Sandy Clay		178 235		12 Well head completion: <b>12"</b> <input type="checkbox"/> Pitless adapter <input checked="" type="checkbox"/> Inches above grade		
Medium Sand with Clay Strips		235 308		13 Well grouted? <input checked="" type="checkbox"/> Yes <input type="checkbox"/> No <input checked="" type="checkbox"/> Neat cement <input checked="" type="checkbox"/> Bentonite <input type="checkbox"/> Depth: From <b>0</b> ft. to <b>10</b> ft.		
Brown Clay		308 344		14 Nearest source of possible contamination: <b>in field</b> ____ ft. ____ Direction <b>none</b> Type ____ Well disinfected upon completion? <input type="checkbox"/> Yes <input checked="" type="checkbox"/> No		
Shale - Blue		344 457		15 Pump: <input checked="" type="checkbox"/> Not installed Manufacturer's name ____ Model number ____ HP ____ Volts ____ Length of drop pipe ____ ft. capacity ____ g.m.p. Type: <input type="checkbox"/> Submersible <input checked="" type="checkbox"/> Turbine <input type="checkbox"/> Jet <input type="checkbox"/> Reciprocating <input type="checkbox"/> Centrifugal <input type="checkbox"/> Other		
(use a second sheet if needed)						
16 Remarks: elevation <b>Drilling Sub-contracted to: Minter-Wilson Drilling Co. License #208 Garden City, Kansas 67846</b> Topography: <input type="checkbox"/> Hill <b>*Lakewood - Perf. - Slot - .125 X 66</b> <input checked="" type="checkbox"/> Slope <b>Set between 235' &amp; 280' and</b> <input type="checkbox"/> Upland <b>" 300' &amp; 334'</b> <input type="checkbox"/> Valley				17 Water well contractor's certification: This well was drilled under my jurisdiction and this report is true to the best of my knowledge and belief. <b>K. I. Drilling Co. 263</b> Business name License No. Address <b>Box 669, Ulysses, Kan.</b> Signed <b>Bob Fisher</b> Date <b>4-21-75</b> Authorized representative		