


WATER WELL PLUGGING RECORD Form WWC-5P KSA 82a-1212 ID NO.

1 LOCATION OF WATER WELL: Fraction 1/4 NE 1/4 SE 1/4 NE 1/4 Section Number 26 Township Number T 28 S Range Number 42 E W
 County: Stanton

Street Rural Address of Well Location: if unknown, distance & direction from nearest town or intersection: If at owner's address, check here
Manter 5 North and 1 East

2 WATER WELL OWNER: Paul Holliday
 RR#, St. Address, Box #: 202 S Knox St
 City, State ZIP Code: Johnson, KS 67855

Global Positioning Systems (GPS) information:
 Latitude: _____ (in decimal degrees)
 Longitude: _____ (in decimal degrees)
 Elevation: _____
 Datum: WGS84. NAD83. NAD27
Collection Method:
 GPS unit (Make Model: _____)
 Digital Map Photo. Topographic Map. Land Survey
 Est. Accuracy: 3 m. 3-5 m. 5-15 m. 15 m

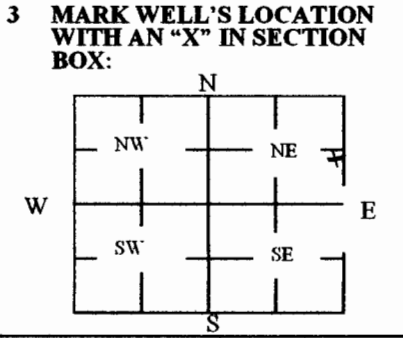

4 DEPTH OF WELL 268 ft.
 WELL'S STATIC WATER LEVEL 254 ft
 WELL WAS USED AS:
 Domestic Public Water Supply Dewatering
 Irrigation Oil Field Water Supply Monitoring
 Feedlot Domestic (Lawn & Garden) Injection Well
 Industrial Air Conditioning Other _____
 Was a chemical/bacteriological sample submitted to Department? Yes No

5 TYPE OF BLANK CASING USED:
 Steel RMP (SR) Wrought Fiberglass Other (Specify below) _____
 PVC ABS Asbestos-Cement Concrete Tile
 Blank casing diameter 5 in. Was casing pulled? Yes No If yes, how much _____
 Casing height above or below land surface 48 in.

6 GROUT PLUG MATERIAL: Neat cement Cement grout Bentonite Other _____
 Grout Plug Intervals: From 4 ft. to 9 ft., From 45 ft. to 50 ft., From _____ to _____ ft.

What is the nearest source of possible contamination:
 Septic tank Seepage pit Fuel Storage Other (specify below) _____
 Sewer lines Pit privy Fertilizer storage
 Watertight sewer lines Sewage lagoon Insecticide storage
 Lateral lines Feedyard Abandoned water well Direction from well? _____
 Cess pool Livestock pens Oil well/Gas well How many feet? _____

FROM	TO	PLUGGING MATERIALS	FROM	TO	PLUGGING MATERIALS
0	4	Top Soil			
4	9	Bentonite			
9	45	sand			
45	50	Bentonite			
50	268	sand			

7 CONTRACTOR'S OR LANDOWNER'S CERTIFICATION: This water well was plugged under my jurisdiction and was completed on (mo/day/year) 5/11/2010 and this record is true to the best of my knowledge and belief. Kansas Water Well Contractor's License No. 775. This Water Well Record was completed on (mo/day/year) 5/12/2010 under the business name of Martin's Well Service by (signature) Kenny Martin

INSTRUCTIONS: Use typewriter or ballpoint pen. Please press firmly and print clearly. Please fill in blanks, underline or circle the correct answers. Send top three copies to Kansas Department of Health and Environment, Bureau of Water, Geology Section, 1000 SW Jackson St., Ste. 420, Topeka, Kansas 66612-1367. Telephone: 785/296-5524. Send one to Water Well Owner and retain one for your records. Visit us at <http://www.kdheks.gov/waterwell/index.html>.

Check one: White Copy Blue Copy Pink Copy