


1 LOCATION OF WATER WELL: County: STANTON Fraction SE 1/4 NE 1/4 NE 1/4 Section Number 27 Township Number T 28 S Range Number R 43W EW

Distance and direction from nearest town or city street address of well if located within city?  
6 MILES NORTHWEST MANTER, KS

2 WATER WELL OWNER: HUBER J M CORP. #27-1 TRESNER  
RR#, St. Address, Box #: 7120 I-40 WEST STE 100 Board of Agriculture, Division of Water Resources  
City, State, ZIP Code: AMARILLO, TX 79106 Application Number: 940487

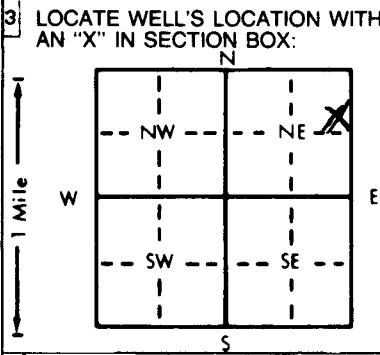

4 DEPTH OF COMPLETED WELL: 400 ft. ELEVATION: ... ft.  
Depth(s) Groundwater Encountered 1. 200 ft. 2. ... ft. 3. ... ft.  
WELL'S STATIC WATER LEVEL: 200 ft. below land surface measured on mo/day/yr 12-13-94  
Pump test data: Well water was 220 ft. after 1 hours pumping 80 gpm  
Est. Yield 80 gpm: Well water was ... ft. after ... hours pumping ... gpm  
Bore Hole Diameter: 11 in. to 400 ft., and ... in. to ... ft.  
WELL WATER TO BE USED AS:  
5 Public water supply 8 Air conditioning 11 Injection well  
1 Domestic 3 Feedlot 6 Oil field water supply 9 Dewatering 12 Other (Specify below)  
2 Irrigation 4 Industrial 7 Lawn and garden only 10 Monitoring well  
Was a chemical/bacteriological sample submitted to Department? Yes ... No  ... If yes, mo/day/yr sample was submitted  
Water Well Disinfected? Yes  No

5 TYPE OF BLANK CASING USED:  
1 Steel 3 RMP (SR) 5 Wrought iron 8 Concrete tile CASING JOINTS: Glued  Clamped ...  
2 PVC 4 ABS 6 Asbestos-Cement 9 Other (specify below) Welded ...  
Blank casing diameter 6 in. to 400 ft., Dia ... in. to ... ft., Dia ... in. to ... ft.  
Casing height above land surface 24 in., weight 2,902 lbs./ft. Wall thickness or gauge No. 280 SDR 21  
TYPE OF SCREEN OR PERFORATION MATERIAL:  
1 Steel 3 Stainless steel 5 Fiberglass 7 PVC 10 Asbestos-cement  
2 Brass 4 Galvanized steel 6 Concrete tile 8 RMP (SR) 11 Other (specify) ...  
SCREEN OR PERFORATION OPENINGS ARE:  
1 Continuous slot 3 Mill slot 5 Gauzed wrapped 8 Saw cut 11 None (open hole)  
2 Louvered shutter 4 Key punched 6 Wire wrapped 9 Drilled holes  
7 Torch cut 10 Other (specify) ...  
SCREEN-PERFORATED INTERVALS: From 300 ft. to 400 ft., From ... ft. to ... ft.  
GRAVEL PACK INTERVALS: From 260 ft. to 400 ft., From ... ft. to ... ft.

6 GROUT MATERIAL: 1 Neat cement 2 Cement grout 3 Bentonite 4 Other HOLE PLUG  
Grout Intervals: From 1 ft. to 20 ft., From ... ft. to ... ft., From ... ft. to ... ft.  
What is the nearest source of possible contamination:  
1 Septic tank 4 Lateral lines 7 Pit privy 10 Livestock pens 14 Abandoned water well  
2 Sewer lines 5 Cess pool 8 Sewage lagoon 11 Fuel storage 15 Oil well/Gas well  
3 Watertight sewer lines 6 Seepage pit 9 Feedyard 12 Fertilizer storage 16 Other (specify below)  
13 Insecticide storage  
Direction from well? Northwest How many feet? 300

FROM	TO	LITHOLOGIC LOG	FROM	TO	PLUGGING INTERVALS
0	2	TOP			
2	65	CLAY			
65	109	SAND			
109	114	CLAY			
114	178	SAND			
178	230	SAND W/CLAY STREAKS			
230	245	SAND STONE & SANDY CLAY			
245	332	BLACK CLAY ROCK & SAND STONE			
332	348	SAND STONE W/SANDY CLAY			
348	400	SAND STONE ROCK SHALE & FINE SAND			

7 CONTRACTOR'S OR LANDOWNER'S CERTIFICATION: This water well was (1) constructed, (2) reconstructed, or (3) plugged under my jurisdiction and was completed on (mo/day/year) 12-13-94 and this record is true to the best of my knowledge and belief. Kansas Water Well Contractor's License No. KWWCL-430 This Water Well Record was completed on (mo/day/year) 12-13-94 under the business name of HOWARD DRLG.CO.BOX 806 BEAVER, OK 73932 by (signature)

INSTRUCTIONS: Use typewriter or ball point pen. PLEASE PRESS FIRMLY and PRINT clearly. Please fill in blanks, underline or circle the correct answer. Send top three copies to Kansas Department of Health and Environment, Bureau of Water, Topeka, Kansas 66620-0001. Telephone: 913-296-5545. Send one to WATER WELL OWNER and retain one for your records.