

(Kingman)


1 LOCATION OF WATER WELL: County: <del>Sedgwick</del>	Fraction NE 1/4 SE 1/4 SW 1/4	Section Number 12	Township Number T 28 S	Range Number R 5 EW
--	----------------------------------	----------------------	---------------------------	------------------------

Distance and direction from nearest town or city street address of well if located within city?

2.1w Cheney

2 WATER WELL OWNER: Mark Jones	RR#, St. Address, Box #: 16494 S.E. 20	Board of Agriculture, Division of Water Resources
City, State, ZIP Code: Cheney, KS 67025		Application Number:

3 LOCATE WELL'S LOCATION WITH AN "X" IN SECTION BOX:

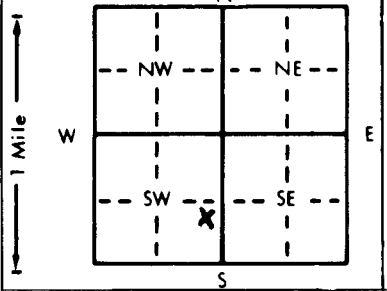

4 DEPTH OF COMPLETED WELL: 56 ft.	ELEVATION: 28 ft.	
Depth(s) Groundwater Encountered 1. 9 ft.	2. 10 ft.	3. 50 ft.
WELL'S STATIC WATER LEVEL: 9 ft. below land surface measured on mo/day/yr 5-9-96		
Pump test data: Well water was _____ ft. after _____ hours pumping _____ gpm		
Est. Yield _____ gpm: Well water was _____ ft. after _____ hours pumping _____ gpm		
Bore Hole Diameter: 10 in. to 56 ft., and _____ in. to _____ ft.		
WELL WATER TO BE USED AS:		
5 Public water supply	8 Air conditioning	11 Injection well
1 Domestic	3 Feedlot	6 Oil field water supply
2 Irrigation	4 Industrial	7 Lawn and garden only
9 Dewatering		
10 Monitoring well		
12 Other (Specify below)		
Was a chemical/bacteriological sample submitted to Department? Yes _____ No <input checked="" type="checkbox"/> _____; If yes, mo/day/yr sample was submitted _____		
Water Well Disinfected? Yes <input checked="" type="checkbox"/> _____ No _____		

5 TYPE OF BLANK CASING USED:	5 Wrought iron	8 Concrete tile	CASING JOINTS: <u>Glued</u>	Clamped _____
1 Steel	3 RMP (SR)	6 Asbestos-Cement	9 Other (specify below)	Welded _____
2 PVC	4 ABS	7 Fiberglass		Threaded _____
Blank casing diameter: 5 in. to 26 ft., Dia _____ in. to _____ ft., Dia _____ in. to _____ ft.				
Casing height above land surface: 18 in., weight _____ lbs./ft.	Wall thickness or gauge No. <u>SPR 26</u>			

TYPE OF SCREEN OR PERFORATION MATERIAL:	7 PVC	10 Asbestos-cement
1 Steel	3 Stainless steel	5 Fiberglass
2 Brass	4 Galvanized steel	6 Concrete tile
		8 RMP (SR)
		9 ABS
		11 Other (specify) _____
		12 None used (open hole)

SCREEN OR PERFORATION OPENINGS ARE:	5 Gauzed wrapped	8 Saw cut	11 None (open hole)
1 Continuous slot	3 Mill slot	6 Wire wrapped	9 Drilled holes
2 Louvered shutter	4 Key punched	7 Torch cut	10 Other (specify) _____

SCREEN-PERFORATED INTERVALS:	From 26 ft. to 56 ft.	From _____ ft. to _____ ft.	From _____ ft. to _____ ft.
GRAVEL PACK INTERVALS:	From 20 ft. to 56 ft.	From _____ ft. to _____ ft.	From _____ ft. to _____ ft.

6 GROUT MATERIAL:	1 Neat cement	2 Cement grout	3 Bentonite	4 Other <u>Baroid-Hole Plug</u>
Grout Intervals: From 3 ft. to 20 ft.	From _____ ft. to _____ ft., From _____ ft. to _____ ft.			
What is the nearest source of possible contamination:				
1 Septic tank	4 Lateral lines	7 Pit privy	10 Livestock pens	14 Abandoned water well
2 Sewer lines	5 Cess pool	8 <u>Sewage lagoon</u>	11 Fuel storage	15 Oil well/Gas well
3 Watertight sewer lines	6 Seepage pit	9 Feedyard	12 Fertilizer storage	16 Other (specify below)
Direction from well? <u>N.E.</u>			How many feet? <u>200</u>	

FROM	TO	LITHOLOGIC LOG	FROM	TO	PLUGGING INTERVALS
0	2	Soil			
2	11	Med. Sand			
11	56	Red Shale			

7 CONTRACTOR'S OR LANDOWNER'S CERTIFICATION: This water well was (1) <u>constructed</u> , (2) reconstructed, or (3) plugged under my jurisdiction and was completed on (mo/day/year) <u>5-9-96</u> and this record is true to the best of my knowledge and belief. Kansas Water Well Contractor's License No. <u>395</u> This Water Well Record was completed on (mo/day/yr) <u>5-10-96</u> under the business name of <u>Craig Roberts Co.</u> by (signature) <u>Craig Roberts</u>
---