

USE TYPEWRITER OR BALL POINT PEN—PRESS FIRMLY, PRINT CLEARLY.

T R EW sec 1/4 1/4 1/4 No.


WATER WELL RECORD
KSA 82a-1201-1215

Kansas State Dept. Of Health
(Water Well Contractors)
Forbes-Bldg. 740
Topeka, Kansas 66620

1 Location of well: County Kingman Township name Vinita Fraction NE 1/4 NE 1/4 SW 1/4 Section number 24 Town number T285 Range number R5W

Distance and direction from nearest town or city: 1 1/2 West 3 Owner of well: Dick Ballinger

Street address of well location if in city: 1 So of Cheney. Address: RR#1 Cheney Kans 67025

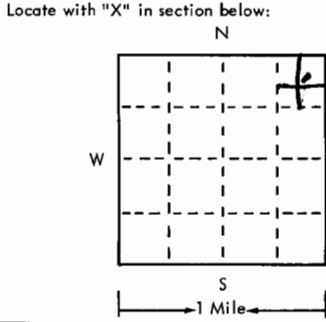

Sketch map:

4 Well depth: 80 ft. Date of completion 5/27/75
Well diameter 9 1/4 in. Bore Hole

5 Cable tool Rotary Driven Dug
 Hollow rod Jetted Bored Reverse rotary

6 Use: Domestic Public supply Industry
 Irrigation Air conditioning Commercial
 Test well

7 Casing: Material Plast Height: above below
Threaded Welded Surface 12 in.
Diam. 5 in. Weight 200 lbs./ft.
80 in. to 80 ft. depth Drive shoe? Yes No
 in. to ft. depth

2	Type and color of material	From	To
	<u>Top Soil (sandy clay)</u>	<u>0'</u>	<u>3'</u>
	<u>Red Clay</u>	<u>0</u>	<u>32'</u>
	<u>Very Hard Red Clay (Keel)</u>	<u>32</u>	<u>70'</u>
	<u>Course red Bed Gravel</u>	<u>70'</u>	<u>80'</u>
	<u>Solid Red Bed.</u>		

8 Screen: Manufacturer Jess - Lowell
Type RMP Dia. 5"
Slot/gauge 1/8 Length 10'
Set between 70 ft. and 80 ft.
Fittings:
Gravel pack Yes No Size range of material 1/8 - 3/8

9 Static water level: 12 ft. below land surface Date 5/27/75

10 Pumping level below land surfaces:
24 ft. after 2 hrs. pumping 30 g.p.m.
 ft. after hrs. pumping g.p.m.
Estimated maximum yield g.p.m.

11 Water sample submitted:
 Yes No Date

12 Well head completion: Stock Well
 Pitless adapter 12 inches above grade

13 Well grouted? Yes No
 Neat cement Bentonite
Depth: From 0 ft. to 14 ft.

14 Nearest source of possible contamination:
ft. 1000 Direction SW Type Fed. let.
Well disinfected upon completion? Yes No

15 Pump: Not installed
Manufacturer's name
Model number HP Volts
Length of drop pipe ft. capacity g.m.p.
Type:
 Submersible Turbine
 Jet Reciprocating
 Centrifugal Other

16 Remarks: elevation

Topography:
 Hill
 Slope
 Upland
 Valley

(use a second sheet if needed)

17 Water well contractor's certification:
This well was drilled under my jurisdiction and this report is true to the best of my knowledge and belief.

Wells Drilling 112
Business name License No.
Address 1030 Highway 54E
Signed Del Wells Date 5/29/75
Authorized representative

Kingman Inc.