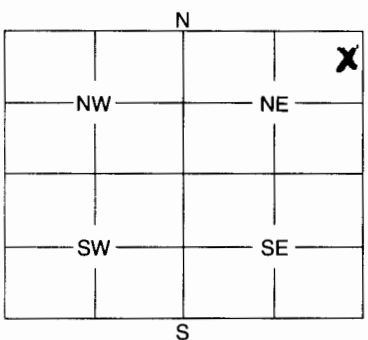


1	LOCATION OF WATER WELL:	Fraction	Section Number	Township Number	Range Number
County:	<i>Kingman</i>	$\frac{1}{4}$ NE $\frac{1}{4}$ NE $\frac{1}{4}$ NE	<i>28</i>	<i>28</i>	<i>5</i> EW

Distance and direction from nearest town or city street address of well if located within city?  
*From MURDOCK 4 EAST TO SE 140TH Ave 2 South Cross Bridge 1st House on West Side*


2	WATER WELL OWNER:	RR #, St. Address, Box #:	Board of Agriculture, Division of Water Resources
	<i>Glen Bolinger</i>	<i>443 SE 140TH Ave</i>	Application Number:
		<i>Cheney, KS 67025</i>	

3	MARK WELL'S LOCATION WITH AN "X" IN SECTION BOX:	4	DEPTH OF WELL ..... <i>40</i> ..... ft.
			WELL'S STATIC WATER LEVEL ..... <i>22</i> ..... ft.
			WELL WAS USED AS:
		<input checked="" type="radio"/> 1 Domestic	5 Public Water Supply
		<input type="radio"/> 2 Irrigation	6 Oil Field Water Supply
		<input type="radio"/> 3 Feedlot	7 Domestic (Lawn & Garden)
		<input type="radio"/> 4 Industrial	8 Air Conditioning
			9 Dewatering
			10 Monitoring Well
			11 Injection Well
			12 Other .....
		Was a chemical / bacteriological sample submitted to Department? Yes ..... No <input checked="" type="checkbox"/>	
		If yes, mo/day/yr sample was submitted .....	
		Water Well Disinfected: Yes <input checked="" type="checkbox"/> No .....	

5	TYPE OF BLANK CASING USED:
	1 Steel    3 RMP (SR)    5 Wrought    7 Fiberglass    9 Other (Specify below)
	2 PVC    4 ABS    6 Asbestos-Cement    8 Concrete Tile
	Blank casing diameter ..... <i>4</i> ..... in.    Was casing pulled?    Yes <input checked="" type="checkbox"/> No .....    If yes, how much ..... <i>3 ft</i> .....
	Casing height above or below land surface ..... <i>36</i> ..... in.

6	GROUT PLUG MATERIAL:	1 Neat cement	2 Cement grout	<input checked="" type="radio"/> 3 Bentonite	4 Other <i>Portland Cement</i>
	Grout Plug Intervals:	From <i>40</i> ft. to <i>3</i> ft.,	From ..... ft. to ..... ft.,	From <i>3</i> to <i>0</i> ft.	
	What is the nearest source of possible contamination:				
	<input type="checkbox"/> 1 Septic tank	<input type="checkbox"/> 6 Seepage pit	<input type="checkbox"/> 11 Fuel storage	<input type="checkbox"/> 16 Other (specify below)	
	<input type="checkbox"/> 2 Sewer lines	<input type="checkbox"/> 7 Pit privy	<input type="checkbox"/> 12 Fertilizer storage		
	<input type="checkbox"/> 3 Watertight sewer lines	<input type="checkbox"/> 8 Sewage lagoon	<input type="checkbox"/> 13 Insecticide storage		
	<input type="checkbox"/> 4 Lateral lines	<input type="checkbox"/> 9 Feedyard	<input type="checkbox"/> 14 Abandoned water well		
	<input type="checkbox"/> 5 Cess pool	<input type="checkbox"/> 10 Livestock pens	<input type="checkbox"/> 15 Oil well/Gas well		
	Direction from well? ..... <i>999</i> .....	How many feet? ..... <i>999</i> .....			

FROM	TO	PLUGGING MATERIALS
<i>40</i>	<i>3</i>	<i>Bentonite</i>
<i>3</i>	<i>0</i>	<i>Portland Cement</i>

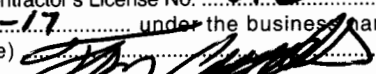7	CONTRACTOR'S OF LANDOWNER'S CERTIFICATION: This water well was plugged under my jurisdiction and was completed on (mo/day/year) <i>2-2-17</i> ..... and this record is true to the best of my knowledge and belief. Kansas Water Well Contractor's License No. <i>672</i> ..... This Water Well Record was completed on (mo/day/year) <i>2-13-17</i> ..... under the business name of <i>Crowdis Water Well Serv.</i> ..... by (signature) 
---	---

INSTRUCTIONS: Use typewriter or ball point pen. Please press firmly and print clearly. Please fill in blanks, underline or circle the correct answers. Send top three copies to Kansas Department of Health and Environment, Bureau of Water, Geology Section, 1000 SW Jackson St., Ste. 420, Topeka, Kansas 66612-1367. Telephone: 785/296-5522. Send one to Water Well Owner and retain one for your records.