


WATER WELL PLUGGING RECORD Form WWC-5P KSA 82a-1212 ID NO.

1 LOCATION OF WATER WELL: Fraction NE 1/4 NW 1/4 SW 1/4 SE 1/4 Section Number 7 Township Number T 28 S Range Number 5

Street/Rural Address of Well Location: if unknown, distance & direction from nearest town or intersection: If at owner's address, check here [] From intersection of SE 20 St. & SE 120 Ave, travel 1215 ft. W to unnamed road then 867 ft. N to gate entrance

2 WATER WELL OWNER: 22nd CES CEVQ USAF RR#, St. Address, Box #: 5300 Hutchinson St., Suite 109 City, State ZIP Code: Wichita, Ks. 67211

Global Positioning Systems (GPS) information: Latitude: 37.6211 Longitude: -97.9031 Elevation: 1423.01

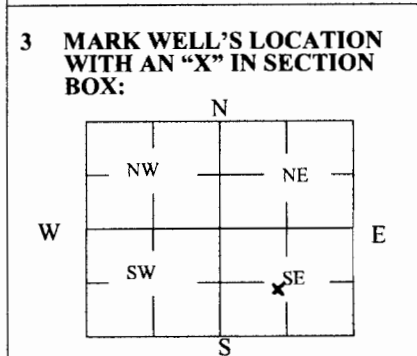

4 DEPTH OF WELL 20.27 ft. WELL'S STATIC WATER LEVEL 11.73 ft. WELL WAS USED AS: [] Domestic [] Irrigation [] Feedlot [] Industrial [] Public Water Supply [] Oil Field Water Supply [] Domestic (Lawn & Garden) [] Air Conditioning [] Dewatering [x] Monitoring [] Injection Well [] Other

5 TYPE OF BLANK CASING USED: [x] Steel [] RMP (SR) [] Wrought [] Fiberglass [] Other (Specify below) [x] PVC [] ABS [] Asbestos-Cement [] Concrete Tile

6 GROUT PLUG MATERIAL: [] Neat cement [] Cement grout [x] Bentonite [] Other

What is the nearest source of possible contamination: [] Septic tank [] Sewer lines [] Watertight sewer lines [] Lateral lines [] Cess pool [] Seepage pit [] Pit privy [] Sewage lagoon [] Feedyard [] Livestock pens [] Fuel storage [] Fertilizer storage [] Insecticide storage [] Abandoned water well [] Oil well/Gas well [] Other (specify below)

Table with 6 columns: FROM, TO, PLUGGING MATERIALS, FROM, TO, PLUGGING MATERIALS. Row 1: 0, 20.27, Bentonite grout.

7 CONTRACTOR'S OR LANDOWNER'S CERTIFICATION: This water well was plugged under my jurisdiction and was completed on (mo/day/year) 8/13/2018 and this record is true to the best of my knowledge and belief.

Send one white copy to Kansas Department of Health & Environment, Geology Section, 1000 SW Jackson Street, Ste. 420, Topeka, KS 66612-1367. Visit us at http://www.kdheks.gov/waterwell/index.html Telephone 785-296-5524.