

USE TYPEWRITER OR BALL POINT PEN-PRESS FIRMLY, PRINT CLEARLY.


WATER WELL RECORD
KSA 82a-1201-1215

Kansas Department of Health and Environment-Division of Environment (Water well Contractors) Topeka, Kansas 66620

8-19-88
50

Location of well: County Kingman Fraction NW 1/4 NW 1/4 NE 1/4 Section number 14 Township number 28 Range number 10 5 E

Distance and direction from nearest town or city: 1/2 W. of Cheney KS on 39th So. Street address of well location if in city:
 3. Owner of well: Tracy Hurn R.R. or street: R#1 Box 67 City, state, zip code: Minerock KS 67111

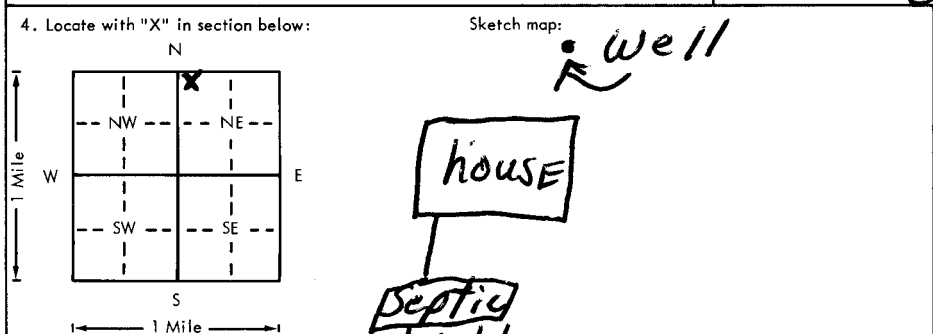

6. Bore hole dia. 4 in. Completion date 6/28/78
Well depth 75 ft.

7. Cable tool Rotary Driven Dug
 Hollow rod Jetted Bored Reverse rotary

8. Use: Domestic Public supply Industry
 Irrigation Air conditioning Stock
 Lawn Oil field water Other

9. Casing: Material Steel Height: Above or below
Threaded Welded Surface 18 in.
RMP PVC Weight 1.50 lbs./ft.
Dia. 5 in. to 75 ft. depth Wall Thickness: inches or
Dia. 5 in. to 75 ft. depth gage No. 200

5. Type and color of material	From	To
Top soil.	0	2
med. sand	2	15
green shale	15	22
red shale	22	58
blue-green shale	58	64
red shale.	64	75

10. Screen: Manufacturer's name Sunflower

Type 200 Dia. 5 in
Slot/gauge 1/16 Length 20 ft
Set between 55 ft. and 75 ft.
Gravel pack? Yes Size range of material 3/8 ft.

11. Static water level: 12 ft. below land surface Date 6/28/78 mo./day/yr.

12. Pumping level below land surfaces:
12 ft. after 1/2 hrs. pumping 10 g.p.m.
Estimated maximum yield 40 g.p.m.

13. Water sample submitted: X Yes X No Date

14. Well head completion: X Pitless adapter 12 Inches above grade

15. Well grouted? Yes
With: Neat cement Bentonite Concrete
Depth: From 3 ft. to 13 ft.

16. Nearest source of possible contamination: 160 ft. Direction SW Type Septic
Well disinfected upon completion? Yes No

17. Pump: Not installed
Manufacturer's name F J W
Model number 10513 HP 1/2 Vol 220
Length of drop pipe 40 ft. capacity 10 g.p.m.
Type: Submersible Turbine
 Jet Reciprocating
 Centrifugal Other

18. Elevation:
Topography:
 Hill
 Slope
 Upland
 Valley

19. Remarks:
Customer to furnish 4'x4'x4' slab around casing at grade per state regulations
Signed X Tracy Hurn

20. Water well contractor's certification:
This well was drilled under my jurisdiction and this report is true to the best of my knowledge and belief.
Wmings Pullins 318
Business name Polwich KS License No.
Address Polwich KS
Signed J. Pullins 6/28/78 Authorized representative