


1 LOCATION OF WATER WELL: County: **Kingman** Fraction: **NE 1/4 NE 1/4 NE 1/4** Section Number: **8** Township Number: **T 28 S** Range Number: **R 6 W**

Distance and direction from nearest town or city street address of well if located within city?
7 Miles East Of Kingman, Kans on 8th ST.

2 WATER WELL OWNER: **Don Dye**
 RR#, St. Address, Box #: **RT#1** Board of Agriculture, Division of Water Resources
 City, State, ZIP Code: **Kingman, Kansas 67068** Application Number:

3 LOCATE WELL'S LOCATION WITH AN "X" IN SECTION BOX:

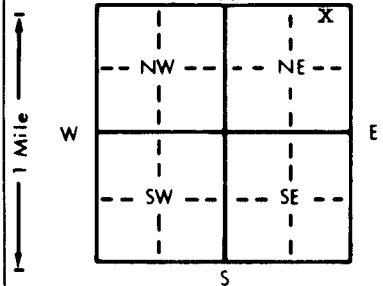

4 DEPTH OF COMPLETED WELL: **51'** ft. ELEVATION:
 Depth(s) Groundwater Encountered 1. **12'** ft. 2. ft. 3. ft.
 WELL'S STATIC WATER LEVEL **7'** ft. below land surface measured on mo/day/yr **Dec 4 - 90**
 Pump test data: Well water was ft. after hours pumping gpm
 Est. Yield gpm: Well water was ft. after hours pumping gpm
 Bore Hole Diameter **8 1/4"** in. to **9'** ft. and **6 3/4"** in. to **51'** ft.
 WELL WATER TO BE USED AS:
 Domestic Feedlot Oil field water supply Dewatering Other (Specify below)
 Irrigation Industrial Lawn and garden only Monitoring well
 Was a chemical/bacteriological sample submitted to Department? Yes No ; If yes, mo/day/yr sample was submitted
 Water Well Disinfected? Yes No

5 TYPE OF BLANK CASING USED:
 Steel RMP (SR) Wrought iron Concrete tile Asbestos-Cement Other (specify below)
 PVC ABS Fiberglass
 Blank casing diameter **6 5/8"** to **9'** ft., Dia. in. to ft., Dia. in. to ft.
 Casing height above land surface **16"** in., weight **9.53** lbs./ft. Wall thickness or gauge No. **10 GA.**

TYPE OF SCREEN OR PERFORATION MATERIAL:
 Steel Stainless steel Fiberglass RMP (SR) Asbestos-cement
 Brass Galvanized steel Concrete tile ABS None used (open hole)
 SCREEN OR PERFORATION OPENINGS ARE:
 Continuous slot Mill slot Gauzed wrapped Saw cut None (open hole)
 Louvered shutter Key punched Wire wrapped Drilled holes
 Torch cut Other (specify)

SCREEN-PERFORATED INTERVALS: From ft. to ft., From ft. to ft.
 GRAVEL PACK INTERVALS: From ft. to ft., From ft. to ft.

6 GROUT MATERIAL: Neat cement Cement grout Bentonite Other
 Grout Intervals: From **Top** ft. to **9'** ft., From ft. to ft., From ft. to ft.
 What is the nearest source of possible contamination:
 Septic tank Lateral lines Pit privy Livestock pens Abandoned water well
 Sewer lines Cess pool Sewage lagoon Fuel storage Oil well/Gas well
 Watertight sewer lines Seepage pit Feedyard Fertilizer storage Other (specify below)
 Insecticide storage
 Direction from well? **North** How many feet? **350'**

FROM	TO	LITHOLOGIC LOG	FROM	TO	PLUGGING INTERVALS
0'	9'	Top Soil.			
9'	10'	Red Bed			
10'	11 1/2'	Vein.			
11 1/2'	44'	Red Bed.			
44'	46'	Vein.			
46'	51'	Red Bed.			

7 CONTRACTOR'S OR LANDOWNER'S CERTIFICATION: This water well was (1) constructed, (2) reconstructed, or (3) plugged under my jurisdiction and was completed on (mo/day/year) **Dec 4 - 90** and this record is true to the best of my knowledge and belief. Kansas Water Well Contractor's License No. **112** This Water Well Record was completed on (mo/day/yr) **Dec 31 - 90** under the business name of **Wells Drilling CO.** by (signature) *Don Dye*