USE TYPEWRITER OR BALL POINT PEN-PRESS FIRMLY, PRINT CLEARLY.

WATER WELL RECORD
KSA 82a-1201-1215

Kansas Department of Health and Environment-Division of Environment
(Water well Contractors)
Topeka, Kansas 66620

1. Location of well:	County: Kingman	Fraction: NW 1/4 SE 1/4 NW 1/4	Section number: 10	Township number: T 28 S	Range number: R 6 E/W

2. Distance and direction from nearest town or city: 2 mi. of Hyatt 54, on Hyatt 17.
Street address of well location if in city: 134W, on So Side

3. Owner of well: Donald J. Henning
R.R. or street: R. R. #1
City, state, zip code: Murdock, Kan. 67111

4. Locate with "X" in section below: Sketch map: Murdock, Kansas

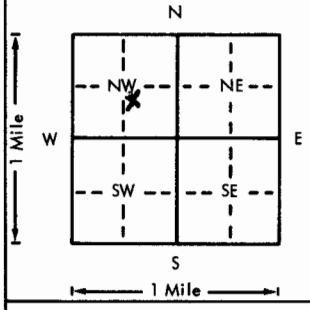

5. Type and color of material	From	To
Red Sandy Topsoil	0	2
Sandy Clay	2	5
Red shale	5	105

(Use a second sheet if needed)

6. Bore hole dia. 11 in. Completion date 10-13-75
Well depth 105 ft.

7. ___ Cable tool X Rotary ___ Driven ___ Dug
___ Hollow rod ___ Jetted ___ Bored ___ Reverse rotary

8. Use: X Domestic ___ Public supply ___ Industry
___ Irrigation ___ Air conditioning ___ Stock
___ Lawn ___ Oil field water ___ Other

9. Casing: Material: Steel Height: Above or below
Threaded ___ Welded X Surface 12 in.
RMP X PVC ___ Weight ___ lbs./ft.
Dia. 5 in. to 105 ft. depth Wall Thickness: inches or
Dia. ___ in. to ___ ft. depth gage No. 200

10. Screen: Manufacturer's name Sunflower Plastic
Type Styrene Dia. 5"
Slot/gauze .050 Length 75'
Set between 30 ft. and 105 ft.
___ ft. and ___ ft.
Gravel pack? yes Size range of material 1/4-1/8"

11. Static water level: mo./day/yr.
22 ft. below land surface Date 10-13-75

12. Pumping level below land surfaces:
___ ft. after ___ hrs. pumping ___ g.p.m.
___ ft. after ___ hrs. pumping ___ g.p.m.
Estimated maximum yield ___ g.p.m.

13. Water sample submitted: mo./day/yr.
___ Yes ___ No Date

14. Well head completion:
X Pitless adapter 12 inches above grade

15. Well grouted? yes
With: ___ Neat cement ___ Bentonite X Concrete
Depth: From 40" to 14 ft.

16. Nearest source of possible contamination: Septic
ft. 100 Direction West Type Tank
Well disinfected upon completion? X Yes ___ No

17. Pump: ___ Not installed
Manufacturer's name Sta-Rite
Model number LP602 HP 3/4 Volts 230
Length of drop pipe 90 ft. capacity 20 g.p.m.
Type:
X Submersible ___ Turbine
___ Jet ___ Reciprocating
___ Centrifugal ___ Other

18. Elevation:
Topography:
X Hill
X Slope
___ Upland
___ Valley

19. Remarks:

20. Water well contractor's certification:
This well was drilled under my jurisdiction and this report is true to the best of my knowledge and belief.
Harp Well + Pump 236
Business name License No.
Address Wichita Kans.
Signed M. Arnold Date 11-4-75
Authorized representative

28 — 6 E/W 10 Sec NW SE NW 1/4 1/4 1/4

Forward the white, blue and pink copies to the Department of Health and Environment

Form WWC-5