USE TYPEWRITER OR BALL POINT PEN-PRESS FIRMLY, PRINT CLEARLY.

WATER WELL RECORD
KSA 82a-1201-1215

Kansas Department of Health and Environment-Division of Environment
(Water well Contractors)
Topeka, Kansas 66620

1. Location of well:	County	Fraction	Section number	Township number	Range number
	Kingman	1/4 cne 1/4 ne 1/4	13	T 28 S	R 6w E/W

2. Distance and direction from nearest town or city: 1½n 1e
Street address of well location if in city: Murdock, Ks.

3. Owner of well: Red Tiger Drlg Co.
R.R. or street: 1720 Ks St Bk Bldg
City, state, zip code: Wichita, Ks. 67202

4. Locate with "X" in section below:

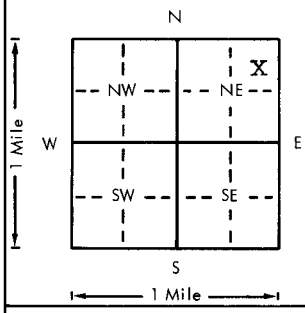

Sketch map:

6. Bore hole dia. 8 in. Completion date
Well depth 108 ft. 1-11-78

7. __ Cable tool X Rotary __ Driven __ Dug
__ Hollow rod __ Jetted __ Bored __ Reverse rotary

8. Use: __ Domestic __ Public supply __ Industry
__ Irrigation __ Air conditioning __ Stock
__ Lawn X Oil field water __ Other

9. Casing: Material _____ Height: Above ~~XXXX~~w
Threaded ____ Welded ____ Surface 12 in.
RMP ____ PVC X Weight 2.8 lbs./ft.
Dia. 5 in. to 108 ft. depth Wall Thickness: inches or
Dia. ____ in. to ____ ft. depth gage No. sch 40

5. Type and color of material	From	To
Top Soil-Clay	0	12
Red Bed	12	108
(Use a second sheet if needed)		

10. Screen: Manufacturer's name Jetstream
Type pvc Dia. 5"
Slot/gauze 1/32" Length 40'
Set between 68 ft. and 108 ft.
____ ft. and ____ ft.
Gravel pack? X Size range of material 1/4-3/4"

11. Static water level: mo./day/yr.
16 ft. below land surface Date 1-11-78

12. Pumping level below land surfaces:
____ ft. after ____ hrs. pumping ____ g.p.m.
____ ft. after ____ hrs. pumping ____ g.p.m.
Estimated maximum yield 50 g.p.m.

13. Water sample submitted: mo./day/yr.
__ Yes X No Date

14. Well head completion:
__ Pitless adapter 12 Inches above grade

15. Well grouted? X
With: __ Neat cement X Bentonite __ Concrete
Depth: From 0 ft. to 10 ft.

16. Nearest source of possible contamination: oil
ft. 65 Direction S Type test
Well disinfected upon completion? ____ Yes X No

17. Pump: X Not installed
Manufacturer's name
Model number ____ HP ____ Volts ____
Length of drop pipe ____ ft. capacity ____ g.p.m.
Type:
__ Submersible __ Turbine
__ Jet __ Reciprocating
__ Centrifugal __ Other

18. Elevation:

Topography:
__ Hill
__ Slope
X Upland
__ Valley

19. Remarks:

20. Water well contractor's certification:
This well was drilled under my jurisdiction and this report is true to the best of my knowledge and belief. 186
~~XXXXXXXXXX~~ Kellys Waterwell
Business name License No.
Address R2 Great Bend, Ks.
Signed Kelly Price Date 8-25-79
Authorized representative

28 T — 6 (W) R — 13 Sec — 1/4 1/4 1/4 — Case 25

Forward the white, blue and pink copies to the Department of Health and Environment

Form WWC-5