

1 LOCATION OF WATER WELL: Fraction 1/4 NW 1/4 NE 1/4 Section Number 24 Township Number T 28 S Range Number R 6 EW


Distance and direction from nearest town or city street address of well if located within city? 10733 SE 40th Murdock, KS 67111

2 WATER WELL OWNER: Grand Investments LLL

RR#, St. Address, Box #: 2418 South Hoover City, State, ZIP Code: Wichita, KS 67215

Board of Agriculture, Division of Water Resources Application Number:

3 LOCATE WELL'S LOCATION WITH AN "X" IN SECTION BOX: 4 DEPTH OF COMPLETED WELL 50 ft. ELEVATION:

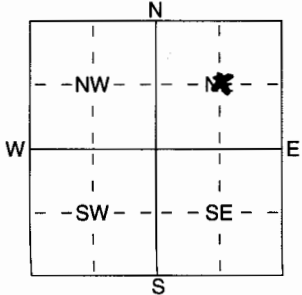

Depth(s) Groundwater Encountered 1 10 ft. 2 ft. 3 ft. WELL'S STATIC WATER LEVEL 10 ft. below land surface measured on mo/day/yr 1-10-06 Pump test data: Well water was ... ft. after ... hours pumping ... gpm Est. Yield 20 gpm: Well water was ... ft. after ... hours pumping ... gpm WELL WATER TO BE USED AS: 5 Public water supply 8 Air conditioning 11 Injection well 2 Irrigation 4 Industrial 7 Domestic (lawn & garden) 10 Monitoring well

Was a chemical/bacteriological sample submitted to Department? Yes No X; If yes, mo/day/yr sample was submitted Water Well Disinfected? Yes X No

5 TYPE OF BLANK CASING USED: 1 Steel 3 RMP (SR) 5 Wrought iron 8 Concrete tile CASING JOINTS: Glued X Clamped

Blank casing diameter 5 in. to 30 ft., Dia 5 in. to ... ft., Dia 5 lbs./ft. Wall thickness or gauge No. SDR 26

TYPE OF SCREEN OR PERFORATION MATERIAL: 1 Steel 3 Stainless Steel 5 Fiberglass 8 RMP (SR) 10 Asbestos-Cement 2 Brass 4 Galvanized Steel 6 Concrete tile 9 ABS 11 Other (Specify) 12 None used (open hole)

SCREEN OR PERFORATION OPENINGS ARE: 1 Continuous slot 3 Mill slot 5 Guazed wrapped 8 Saw cut 11 None (open hole) 2 Louvered shutter 4 Key punched 6 Wire wrapped 9 Drilled holes 10 Other (specify) ... ft. 7 Torch cut 10 Other (specify) ... ft.

SCREEN-PERFORATED INTERVALS: From 30 ft. to 50 ft., From ... ft. to ... ft. GRAVEL PACK INTERVALS: From 20 ft. to 50 ft., From ... ft. to ... ft.

6 GROUT MATERIAL: 1 Neat cement 2 Cement grout 3 Bentonite 4 Other

Grout intervals: From 3 ft. to 20 ft., From ... ft. to ... ft.

What is the nearest source of possible contamination: 1 Septic tank 4 Lateral lines 7 Pit privy 11 Fuel storage 14 Abandoned water well 2 Sewer lines 5 Cess pool 8 Sewage lagoon 12 Fertilizer storage 15 Oil well/Gas well 3 Watertight sewer lines 6 Seepage pit 9 Feedyard 13 Insecticide storage 16 Other (specify below) None

Direction from well? How many feet? Open Field

Table with columns: FROM, TO, LITHOLOGIC LOG, FROM, TO, PLUGGING INTERVALS. Entries include: 0-3 Top soil, 3-10 Red clay, 10-50 Red and Green shale.

7 CONTRACTOR'S OR LANDOWNER'S CERTIFICATION: This water well was constructed, (2) reconstructed, or (3) plugged under my jurisdiction and was completed on (mo/day/year) 2-6-06 1-10-06 and this record is true to the best of my knowledge and belief. Kansas Water Well Contractor's Licence No 238 This Water Well Record was completed on (mo/day/yr) 2-6-06 under the business name of Premier Pump + Well Service Inc. by (signature) Cathy Wanning