


1 LOCATION OF WATER WELL: County: KINGMAN Fraction SE 1/4 SE 1/4 NW 1/4 Section Number 15 Township Number T 28 S Range Number R 6 ~~EW~~

Distance and direction from nearest town or city street address of well if located within city?

1 1/2 Mile West of MURDOCK, Kans.

2 WATER WELL OWNER: Robert Zoeller RR#, St. Address, Box #: 11732NE 20th ST. Board of Agriculture, Division of Water Resources City, State, ZIP Code: Murdock, Kns. 67111 Application Number:

3 LOCATE WELL'S LOCATION WITH AN "X" IN SECTION BOX:

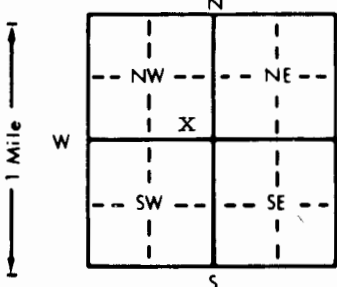

4 DEPTH OF COMPLETED WELL: 64' ft. ELEVATION:

Depth(s) Groundwater Encountered 1. 19' ft. 2. ft. 3. ft.

WELL'S STATIC WATER LEVEL: 16' ft. below land surface measured on mo/day/yr Aug: 1-1998

Pump test data: Well water was ft. after hours pumping gpm

Est. Yield: 10 gpm; Well water was ft. after hours pumping gpm

Bore Hole Diameter: 8 1/4" in. to 64' ft., and in. to ft.

WELL WATER TO BE USED AS: 5 Public water supply 8 Air conditioning 11 Injection well

XXI Domestic 3 Feedlot 6 Oil field water supply 9 Dewatering 12 Other (Specify below)

2 Irrigation 4 Industrial 7 Lawn and garden only 10 Monitoring well

Was a chemical/bacteriological sample submitted to Department? Yes No X; If yes, mo/day/yr sample was submitted Water Well Disinfected? Yes X No

5 TYPE OF BLANK CASING USED: 1 Steel 3 RMP (SR) 5 Wrought iron 8 Concrete tile CASING JOINTS: Glued XX Clamped 2 PVCXX 4 ABS 6 Asbestos-Cement 9 Other (specify below) Welded 7 Fiberglass Threaded

Blank casing diameter 5" in. to 30" ft., Dia in. to ft., Dia in. to ft.

Casing height above land surface 14" in., weight 2.355 lbs./ft. Wall thickness or gauge No. 2.14

TYPE OF SCREEN OR PERFORATION MATERIAL: 1 Steel 3 Stainless steel 5 Fiberglass 7 PVC XX 10 Asbestos-cement

2 Brass 4 Galvanized steel 6 Concrete tile 8 RMP (SR) 11 Other (specify)

SCREEN OR PERFORATION OPENINGS ARE: 1 Continuous slot 3 Mill slot 5 Gauzed wrapped XX Saw cut 11 None (open hole)

2 Louvered shutter 4 Key punched 6 Wire wrapped 9 Drilled holes

7 Torch cut 10 Other (specify)

SCREEN-PERFORATED INTERVALS: From 30' ft. to 64' ft., From ft. to ft.

GRAVEL PACK INTERVALS: From ft. to ft., From ft. to ft.

From 64' ft. to 19' ft., From ft. to ft.

6 GROUT MATERIAL: 1 Neat cement 2 Cement grout XX3 Bentonite 4 Other

Grout Intervals: From 19' ft. to 0' ft., From ft. to ft., From ft. to ft.

What is the nearest source of possible contamination: 10 Livestock pens 14 Abandoned water well

XX 1 Septic tank 4 Lateral lines 7 Pit privy 11 Fuel storage 15 Oil well/Gas well

2 Sewer lines 5 Cess pool 8 Sewage lagoon 12 Fertilizer storage 16 Other (specify below)

3 Watertight sewer lines 6 Seepage pit 9 Feedyard 13 Insecticide storage

Direction from well? North West How many feet? 120'

FROM	TO	LITHOLOGIC LOG	FROM	TO	PLUGGING INTERVALS
0'	4'	Top Soil.			
4'	14'	Loose Clay & Shale.			
14'	17'	Fine Sand.			
17'	19'	Clay.			
19'	25'	Fine Sand w/Shale Breaks.			
25'	30'	Fine Sand w/Shale Breaks.			
30'	64'	Red Rock (Broken).			

7 CONTRACTOR'S OR LANDOWNER'S CERTIFICATION: This water well was (1) constructed, (2) reconstructed, or (3) plugged under my jurisdiction and was completed on (mo/day/year) Aug. 1 1998 and this record is true to the best of my knowledge and belief. Kansas Water Well Contractor's License No. 112 This Water Well Record was completed on (mo/day/yr) Aug 21 1998 under the business name of Wells Drilling CO. by (signature) Gal Wells