


1 LOCATION OF WATER WELL: County: **Kingman** Fraction: **NW 1/4 SW 1/4 NW 1/4** Section Number: **29** Township Number: **T 28 S** Range Number: **R 6 W EW**

Distance and direction from nearest town or city street address of well if located within city?
2 south of Belmont

2 WATER WELL OWNER: **Adrian Woran**
 RR#, St. Address, Box #: **10642 E 70 Ave** Board of Agriculture, Division of Water Resources
 City, State, ZIP Code: **Rago, Ks. 67128** Application Number:

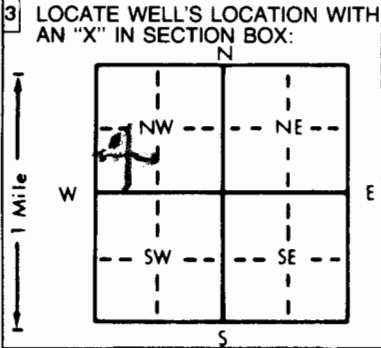

4 DEPTH OF COMPLETED WELL: **42** ft. ELEVATION:
 Depth(s) Groundwater Encountered 1. **32** ft. 2. ft. 3. ft.
 WELL'S STATIC WATER LEVEL: **5 1/2** ft. below land surface measured on mo/day/yr **5-1-98**
 Pump test data: Well water was ft. after hours pumping gpm
 Est. Yield **12** gpm: Well water was ft. after hours pumping gpm
 Bore Hole Diameter: **9** in. to **42** ft., and in. to ft.
 WELL WATER TO BE USED AS:
 5 Public water supply 8 Air conditioning 11 Injection well
 1 Domestic 3 Feedlot 6 Oil field water supply 9 Dewatering 12 Other (Specify below)
 2 Irrigation 4 Industrial 7 Lawn and garden only 10 Monitoring well
 Was a chemical/bacteriological sample submitted to Department? Yes ; If yes, mo/day/yr sample was submitted
 Water Well Disinfected? Yes No

5 TYPE OF BLANK CASING USED:
 1 Steel 3 RMP (SR) 5 Wrought iron 8 Concrete tile CASING JOINTS: ~~Clamped~~ Clamped
 2 PVC 4 ABS 6 Asbestos-Cement 9 Other (specify below) Welded
 7 Fiberglass Threaded
 Blank casing diameter: ~~53~~ in. to **34** ft., Dia. in. to ft., Dia. in. to ft.
 Casing height above land surface: **24** in., weight lbs./ft. Wall thickness or gauge No. **.210**
 TYPE OF SCREEN OR PERFORATION MATERIAL:
 1 Steel 3 Stainless steel 5 Fiberglass 7 PVC 10 Asbestos-cement
 2 Brass 4 Galvanized steel 6 Concrete tile 8 RMP (SR) 11 Other (specify)
 9 ABS 12 None used (open hole)
 SCREEN OR PERFORATION OPENINGS ARE:
 1 Continuous slot 3 Mill slot 5 Gauzed wrapped 8 Saw cut 11 None (open hole)
 2 Louvered shutter 4 Key punched 6 Wire wrapped 9 Drilled holes
 7 Torch cut 10 Other (specify)
 SCREEN-PERFORATED INTERVALS: From **36 1/2** ft. to **25** ft., From **30** ft. to ft.
 From ft. to ft., From ft. to ft.
 GRAVEL PACK INTERVALS: From **23** ft. to **42** ft., From ft. to ft.
 From ft. to ft., From ft. to ft.

6 GROUT MATERIAL: 1 Neat cement 2 Cement grout 3 Bentonite 4 Other
 Grout Intervals: From **3** ft. to **23** ft., From ft. to ft., From ft. to ft., From ft. to ft.
 What is the nearest source of possible contamination:
 1 Septic tank ~~lines~~ 7 Pit privy 10 Livestock pens 14 Abandoned water well
 2 Sewer lines ~~5 Cess pool~~ 8 Sewage lagoon 11 Fuel storage 15 Oil well/Gas well
 3 Watertight sewer lines 6 Seepage pit 9 Feedyard 12 Fertilizer storage 16 Other (specify below)
 13 Insecticide storage
 Direction from well? **south**: How many feet? **100**

FROM	TO	LITHOLOGIC LOG	FROM	TO	PLUGGING INTERVALS
1	3	soil			
3	10	clay			
10	32	sand			
32	33	medium sand			
33	34 1/2	shale			

7 CONTRACTOR'S OR LANDOWNER'S CERTIFICATION: This water well was (1) constructed, (2) reconstructed, or (3) plugged under my jurisdiction and was completed on (mo/day/year) **5-1-98** and this record is true to the best of my knowledge and belief. Kansas Water Well Contractor's License No. **140** This Water Well Record was completed on (mo/day/yr) under the business name of **Lyman Inc.** by (signature) *Adrian Woran*