


1 LOCATION OF WATER WELL: Fraction NE 1/4 NW 1/4 NE 1/4 Section Number 20 Township Number T 28 S Range Number R 7 EW

Distance and direction from nearest town or city street address of well if located within city?
 1 Mile South 3/4 Mile East Of Kingman, Kns.

2 WATER WELL OWNER: Don Schmitz
 RR#, St. Address, Box #: RT#3 Board of Agriculture, Division of Water Resources
 City, State, ZIP Code: Kingman, Kans 67068 Application Number:

3 LOCATE WELL'S LOCATION WITH AN "X" IN SECTION BOX:

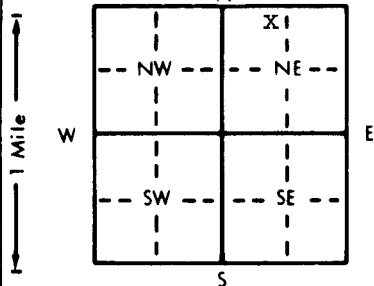

4 DEPTH OF COMPLETED WELL: 56' ft. ELEVATION:
 Depth(s) Groundwater Encountered 1. 17' ft. 2. ft. 3. ft.
 WELL'S STATIC WATER LEVEL 16' ft. below land surface measured on mo/day/yr June 10 96
 Pump test data: Well water was NA ft. after hours pumping gpm
 Est. Yield 15 gpm: Well water was ft. after hours pumping gpm
 Bore Hole Diameter 7 7/8" in. to 56' ft., and in. to ft.
 WELL WATER TO BE USED AS:
 5 Public water supply 8 Air conditioning 11 Injection well
 X1 Domestic 3 Feedlot 6 Oil field water supply 9 Dewatering 12 Other (Specify below)
 2 Irrigation 4 Industrial 7 Lawn and garden only 10 Monitoring well
 Was a chemical/bacteriological sample submitted to Department? Yes No X; If yes, mo/day/yr sample was submitted
 Water Well Disinfected? Yes X No

5 TYPE OF BLANK CASING USED:
 1 Steel 3 RMP (SR) 5 Wrought iron 8 Concrete tile CASING JOINTS: Glued X Clamped
 X 2 PVC 4 ABS 6 Asbestos-Cement 9 Other (specify below) Welded
 Blank casing diameter 5" in. to 48" ft., Dia. in. to ft., Dia. in. to ft.
 Casing height above land surface 16" in., weight 160 lbs./ft. Wall thickness or gauge No. SDR 26
 TYPE OF SCREEN OR PERFORATION MATERIAL:
 1 Steel 3 Stainless steel 5 Fiberglass 8 RMP (SR) 10 Asbestos-cement
 2 Brass 4 Galvanized steel 6 Concrete tile 9 ABS 12 None used (open hole)
 SCREEN OR PERFORATION OPENINGS ARE:
 1 Continuous slot 3 Mill slot 5 Gauzed wrapped X Saw cut 11 None (open hole)
 2 Louvered shutter 4 Key punched 6 Wire wrapped 9 Drilled holes
 7 Torch cut 10 Other (specify)
 SCREEN-PERFORATED INTERVALS: From 56' ft. to 48' ft., From ft. to ft.
 GRAVEL PACK INTERVALS: From 56' ft. to 41' ft., From 40' ft. to 22' ft.

6 GROUT MATERIAL: 1 Neat cement 2 Cement grout X3 Bentonite 4 Other
 Grout intervals: From 41' ft. to 40' ft., From 22' ft. to 2' ft., From ft. to ft.
 What is the nearest source of possible contamination:
 1 Septic tank 4 Lateral lines 7 Pit privy X10 Livestock pens 14 Abandoned water well
 2 Sewer lines 5 Cess pool 8 Sewage lagoon 11 Fuel storage 15 Oil well/Gas well
 3 Watertight sewer lines 6 Seepage pit 9 Feedyard 12 Fertilizer storage 16 Other (specify below)
 13 Insecticide storage
 Direction from well? West How many feet? App: 500'

FROM	TO	LITHOLOGIC LOG	FROM	TO	PLUGGING INTERVALS
0'	3'	Top Soil.			
3'	6'	Red Clay.			
6'	17'	Fine Sand.			
17'	29'	Silty Sand.			
29'	36'	Medium Fine Sand.			
36'	46'	Clay.			
46'	56'	Course Sand.			
		Red Bed.			

7 CONTRACTOR'S OR LANDOWNER'S CERTIFICATION: This water well was (1) constructed, (2) reconstructed, or (3) plugged under my jurisdiction and was completed on (mo/day/year) June 10 96 and this record is true to the best of my knowledge and belief. Kansas Water Well Contractor's License No. 112 This Water Well Record was completed on (mo/day/yr) July 5 1996 under the business name of Wells Drilling Co. by (signature) Neal Wells

INSTRUCTIONS: Use typewriter or ball point pen. PLEASE PRESS FIRMLY and PRINT clearly. Please fill in blanks, underline or circle the correct answers. Send top three copies to Kansas Department of Health and Environment, Bureau of Water, Topeka, Kansas 66620-0001. Telephone: 913-296-5545. Send one to WATER WELL OWNER and retain one for your records.