


1 LOCATION OF WATER WELL: County: Kingman Fraction: NW 1/4 NE 1/4 NW 1/4 Section Number: 5 Township Number: T28 219 S Range Number: R 7 EW

Distance and direction from nearest town or city street address of well if located within city?  
SW corner of Avenue "C" and spruce street, Kingman, KS

2 WATER WELL OWNER: City of Kingman RR#, St. Address, Box #: 324 N. Main City, State, ZIP Code: Kingman, KS 67068 Board of Agriculture, Division of Water Resources Application Number: MW-1

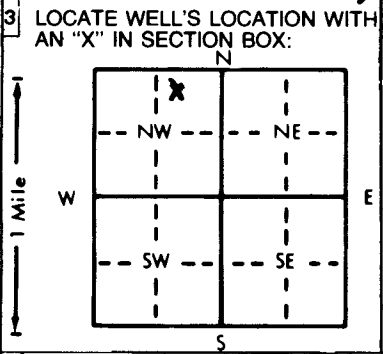

4 DEPTH OF COMPLETED WELL: 30' ft. ELEVATION: ..... ft.  
 Depth(s) Groundwater Encountered 1. 15.08 ft. 2. .... ft. 3. .... ft.  
 WELL'S STATIC WATER LEVEL 15.08 ft. below land surface measured on mo/day/yr 6-19-89  
 Pump test data: Well water was ..... ft. after ..... hours pumping ..... gpm  
 Est. Yield ..... gpm: Well water was ..... ft. after ..... hours pumping ..... gpm  
 Bore Hole Diameter: 8 in. to 30 ft., and ..... in. to ..... ft.  
 WELL WATER TO BE USED AS: 5 Public water supply 8 Air conditioning 11 Injection well  
 1 Domestic 3 Feedlot 6 Oil field water supply 9 Dewatering 12 Other (Specify below)  
 2 Irrigation 4 Industrial 7 Lawn and garden only 10 Monitoring well  
 Was a chemical/bacteriological sample submitted to Department? Yes.....No.....X.....; If yes, mo/day/yr sample was submitted  
 Water Well Disinfected? Yes No X

5 TYPE OF BLANK CASING USED: 1 Steel 3 RMP (SR) 6 Asbestos-Cement 9 Other (specify below) Welded .....  
2 PVC 4 ABS 7 Fiberglass ..... Threaded: X  
 Blank casing diameter: 2 in. to 15 ft., Dia. .... in. to .... ft., Dia. .... in. to .... ft.  
 Casing height above land surface: Flusl in., weight ..... lbs./ft. Wall thickness or gauge No. sch 40 PVC

TYPE OF SCREEN OR PERFORATION MATERIAL: 7 PVC 10 Asbestos-cement  
 1 Steel 3 Stainless steel 5 Fiberglass 8 RMP (SR) 11 Other (specify) .....  
 2 Brass 4 Galvanized steel 6 Concrete tile 9 ABS 12 None used (open hole)

SCREEN OR PERFORATION OPENINGS ARE: 5 Gauzed wrapped 8 Saw cut 11 None (open hole)  
 1 Continuous slot 3 Mill slot 6 Wire wrapped 9 Drilled holes  
 2 Louvered shutter 4 Key punched 7 Torch cut 10 Other (specify) .....

SCREEN-PERFORATED INTERVALS: From 30 ft. to 15 ft., From ..... ft. to ..... ft.  
 From ..... ft. to ..... ft., From ..... ft. to ..... ft.  
 GRAVEL PACK INTERVALS: From 30 ft. to 13 ft., From ..... ft. to ..... ft.  
 From ..... ft. to ..... ft., From ..... ft. to ..... ft.

6 GROUT MATERIAL: 1 Neat cement 2 Cement grout 3 Bentonite 4 Other Waterless grout  
 Grout Intervals: From 13 ft. to surface ft., From ..... ft. to ..... ft., From ..... ft. to ..... ft.  
 What is the nearest source of possible contamination:  
 1 Septic tank 4 Lateral lines 7 Pit privy 10 Livestock pens 14 Abandoned water well  
 2 Sewer lines 5 Cess pool 8 Sewage lagoon 11 Fuel storage 15 Oil well/Gas well  
 3 Watertight sewer lines 6 Seepage pit 9 Feedyard 12 Fertilizer storage 16 Other (specify below)  
 13 Insecticide storage  
 Direction from well? West How many feet? 50

FROM	TO	LITHOLOGIC LOG	FROM	TO	PLUGGING INTERVALS
0	15	Brown, moist, silty SAND medium to fine grained			
15	30	Red brown, saturated, silty SAND same as above			
Grout variance and casing height variance is granted by KDH/E					

7 CONTRACTOR'S OR LANDOWNER'S CERTIFICATION: This water well was (1) constructed, (2) reconstructed, or (3) plugged under my jurisdiction and was completed on (mo/day/year) 6-19-89 and this record is true to the best of my knowledge and belief. Kansas Water Well Contractor's License No. 996 This Water Well Record was completed on (mo/day/yr) 9/10/89 under the business name of Amber Trust Inc. by (signature) [Signature]