


1 LOCATION OF WATER WELL: County: Kingman Fraction Center of Quarter 1/4 Section Number 2 Township Number T 28 S Range Number R 7W

Distance and direction from nearest town or city street address of well if located within city?

2 miles east 1 1/2 south of Kingman, Kns.

2 WATER WELL OWNER: Marland Bergman RR#, St. Address, Box #: RT#1 Harper, Kansas 67058 City, State, ZIP Code: Harper, Kansas 67058 Board of Agriculture, Division of Water Resources Application Number:

3 LOCATE WELL'S LOCATION WITH AN "X" IN SECTION BOX:

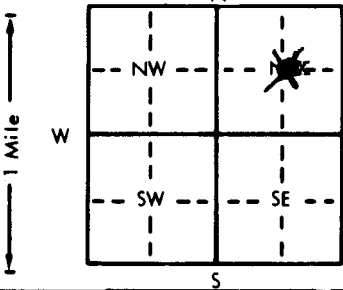

4 DEPTH OF COMPLETED WELL: 50' ft. ELEVATION: 40' ft. Depth(s) Groundwater Encountered 1. 40' ft. 2. ft. 3. ft. WELL'S STATIC WATER LEVEL: 31' ft. below land surface measured on mo/day/yr Jan 10 1990

Pump test data: Well water was NA ft. after hours pumping gpm Est. Yield NA gpm Well water was NA ft. after hours pumping gpm Bore Hole Diameter: 7 7/8 in. to 50' ft., and in. to ft. WELL WATER TO BE USED AS: 5 Public water supply 8 Air conditioning 11 Injection well XX Domestic 3 Feedlot 6 Oil field water supply 9 Dewatering 12 Other (Specify below) 2 Irrigation 4 Industrial 7 Lawn and garden only 10 Monitoring well Was a chemical/bacteriological sample submitted to Department? Yes No X If yes, mo/day/yr sample was submitted Water Well Disinfected? Yes No X

5 TYPE OF BLANK CASING USED: 1 Steel 3 RMP (SR) 5 Wrought iron 8 Concrete tile CASING JOINTS: Glued XX Clamped XX2 PVC 4 ABS 6 Asbestos-Cement 9 Other (specify below) Welded 7 Fiberglass Threaded

Blank casing diameter: 5" in. to 40' ft., Dia. 16" in. to 160 lbs./ft. Wall thickness or gauge No. SDR 26 Casing height above land surface: 16" in., weight 160 lbs./ft. Wall thickness or gauge No. SDR 26

TYPE OF SCREEN OR PERFORATION MATERIAL: 1 Steel 3 Stainless steel 5 Fiberglass 8 RMP (SR) 10 Asbestos-cement 2 Brass 4 Galvanized steel 6 Concrete tile 9 ABS 11 Other (specify) 12 None used (open hole) XX 7 PVC

SCREEN OR PERFORATION OPENINGS ARE: 1 Continuous slot 3 Mill slot 5 Gauzed wrapped 7 Torch cut 9 Drilled holes 11 None (open hole) 2 Louvered shutter 4 Key punched 6 Wire wrapped 9 Drilled holes 10 Other (specify)

SCREEN-PERFORATED INTERVALS: From 50' ft. to 40' ft., From ft. to ft. GRAVEL PACK INTERVALS: From 50' ft. to 16' ft., From ft. to ft.

6 GROUT MATERIAL: XX1 Neat cement 2 Cement grout 3 Bentonite 4 Other Grout Intervals: From 16' ft. to 0 ft., From ft. to ft., From ft. to ft., From ft. to ft.

What is the nearest source of possible contamination: 1 Septic tank 4 Lateral lines 7 Pit privy 10 Livestock pens 14 Abandoned water well 2 Sewer lines 5 Cess pool 8 Sewage lagoon 11 Fuel storage 15 Oil well/Gas well 3 Watertight sewer lines 6 Seepage pit 9 Feedyard 12 Fertilizer storage X16 Other (specify below) Center of pasture 13 Insecticide storage

Direction from well? How many feet?

Table with columns: FROM, TO, LITHOLOGIC LOG, FROM, TO, PLUGGING INTERVALS. Rows include: 0' to 3' top soil, 3' to 24' red bed, 24' to 29' Broken red bed, 29' to 40' red bed, 40' to 50' Porus broken red bed.

7 CONTRACTOR'S OR LANDOWNER'S CERTIFICATION: This water well was (1) constructed, (2) reconstructed, or (3) plugged under my jurisdiction and was completed on (mo/day/year) Feb 5 1990 and this record is true to the best of my knowledge and belief. Kansas Water Well Contractor's License No. 112 This Water Well Record was completed on (mo/day/yr) Mar 12 90 under the business name of Wells Drilling Co. by (signature) Dal Wells