


1 LOCATION OF WATER WELL: Fraction NW 1/4 NW 1/4 NW 1/4 Section Number 5 Township Number T 28 S Range Number R 7 EW

County: Kingman Distance and direction from nearest town or city street address of well if located within city? 257 West C, Kingman

2 WATER WELL OWNER: Ed Brumer  
 RR#, St. Address, Box #: 257 West C  
 City, State, ZIP Code: Kingman KS 67068  
 Board of Agriculture, Division of Water Resources  
 Application Number:

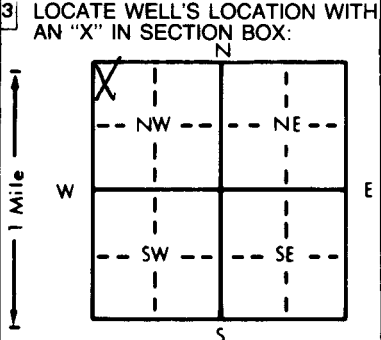

4 DEPTH OF COMPLETED WELL: 15.0 ft. ELEVATION:  
 Depth(s) Groundwater Encountered 1. 9.5 ft. 2. ft. 3. ft.  
 WELL'S STATIC WATER LEVEL: 7.18 ft. below land surface measured on mo/day/yr 1/8/93  
 Pump test data: Well water was ft. after hours pumping gpm  
 Est. Yield gpm; Well water was ft. after hours pumping gpm  
 Bore Hole Diameter: 8 in. to ft., and in. to ft.  
 WELL WATER TO BE USED AS:  
 1 Domestic 3 Feedlot 6 Oil field water supply 9 Dewatering 12 Other (Specify below)  
 2 Irrigation 4 Industrial 7 Lawn and garden only 10 Monitoring well  
 Was a chemical/bacteriological sample submitted to Department? Yes No X; If yes, mo/day/yr sample was submitted  
 Water Well Disinfected? Yes No X

5 TYPE OF BLANK CASING USED:  
 1 Steel 3 RMP (SR) 5 Wrought iron 8 Concrete tile CASING JOINTS: Glued Clamped  
 2 PVC 4 ABS 6 Asbestos-Cement 9 Other (specify below) Welded  
 7 Fiberglass Threaded Flush  
 Blank casing diameter 2 in. to ft., Dia. in. to ft., Dia. in. to ft.  
 Casing height above land surface: Flush in., weight 70.3 lbs./ft. Wall thickness or gauge No. 154  
 TYPE OF SCREEN OR PERFORATION MATERIAL:  
 1 Steel 3 Stainless steel 5 Fiberglass 7 PVC 10 Asbestos-cement  
 2 Brass 4 Galvanized steel 6 Concrete tile 8 RMP (SR) 11 Other (specify)  
 12 None used (open hole)  
 SCREEN OR PERFORATION OPENINGS ARE:  
 1 Continuous slot 3 Mill slot 5 Gauzed wrapped 8 Saw cut 11 None (open hole)  
 2 Louvered shutter 4 Key punched 6 Wire wrapped 9 Drilled holes  
 7 Torch cut 10 Other (specify)  
 SCREEN-PERFORATED INTERVALS: From 5.0 ft. to 15.0 ft., From ft. to ft.  
 GRAVEL PACK INTERVALS: From 4.0 ft. to 15.0 ft., From ft. to ft.

6 GROUT MATERIAL: 1 Neat cement 2 Cement grout 3 Bentonite 4 Other  
 Grout Intervals: From 4.0 ft. to 1.0 ft., From ft. to ft., From ft. to ft.  
 What is the nearest source of possible contamination:  
 1 Septic tank 4 Lateral lines 7 Pit privy 10 Livestock pens 14 Abandoned water well  
 2 Sewer lines 5 Cess pool 8 Sewage lagoon 11 Fuel storage 15 Oil well/Gas well  
 3 Watertight sewer lines 6 Seepage pit 9 Feedyard 12 Fertilizer storage 16 Other (specify below)  
 13 Insecticide storage  
 Direction from well? South How many feet? 60

FROM	TO	LITHOLOGIC LOG	FROM	TO	PLUGGING INTERVALS
0.0	5.0	Shaley sand to sandy shale			
5.0	9.5	Sand, tan, fine to very fine grain, moderately sorted			
9.5	15.0	Sand, Tan, very fine to fine grain, well sorted wet			
Flush Mount Waiver granted on 12-10-92 for Ed Brumer Plumbing & Electric KDHE 02048792 by Don Taylor					

7 CONTRACTOR'S OR LANDOWNER'S CERTIFICATION: This water well was (1) constructed, (2) reconstructed, or (3) plugged under my jurisdiction and was completed on (mo/day/year) 1/8/93 and this record is true to the best of my knowledge and belief. Kansas Water Well Contractor's License No. 531 This Water Well Record was completed on (mo/day/yr) 1/21/93 under the business name of GSI by (signature) Allison Irwin