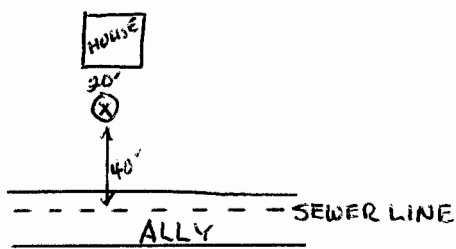


USE TYPEWRITER OR BALL POINT PEN-PRESS FIRMLY, PRINT CLEARLY.

WATER WELL RECORD
KSA 82a-1201-1215

Kansas Department of Health and Environment-Division of Environment (Water well Contractors) Topeka, Kansas 66620

1. Location of well: County KINGMAN		Fraction SE 1/4 NE 1/4 NW 1/4		Section number 5		Township number T 28 S R 7		Range number 7 EAW	
2. Distance and direction from nearest town or city: Street address of well location if in city: 247 B. EAST KINGMAN, KS.				3. Owner of well: LAURENCE BRITAIN R.R. or street: 247 B. EAST City, state, zip code: KINGMAN, KS. 67068					
4. Locate with "X" in section below: N W E S 1 Mile 1 Mile				Sketch map: 		6. Bore hole dia. 16 in. Completion date 6/5/79 Well depth 46 ft.			
5. Type and color of material				From		To		7. <input type="checkbox"/> Cable tool <input checked="" type="checkbox"/> Rotary <input type="checkbox"/> Driven <input type="checkbox"/> Dug <input type="checkbox"/> Hollow rod <input type="checkbox"/> Jetted <input type="checkbox"/> Bored <input type="checkbox"/> Reverse rotary	
								8. Use: <input type="checkbox"/> Domestic <input type="checkbox"/> Public supply <input type="checkbox"/> Industry <input type="checkbox"/> Irrigation <input type="checkbox"/> Air conditioning <input type="checkbox"/> Stock <input checked="" type="checkbox"/> Lawn <input type="checkbox"/> Oil field water <input type="checkbox"/> Other	
TOP SOIL				0		1		9. Casing: Material PLST Height: Above or below Threaded <input type="checkbox"/> Welded GLUE Surface 12 in. RMP <input type="checkbox"/> PVC 5.440 Weight 2.827 lbs./ft. Dia. 5 in. to 36 ft. depth; Wall Thickness: inches or Dia. <input type="checkbox"/> in. to <input type="checkbox"/> ft. depth; gage No. 258	
CLAY				1		12		10. Screen: Manufacturer's name PUMPCO Type PVC Dia. <input type="checkbox"/> Slot/gauze .030 Length <input type="checkbox"/> Set between 26 ft. and 46 ft. <input type="checkbox"/> ft. and <input type="checkbox"/> ft. Gravel pack? <input checked="" type="checkbox"/> Size range of material 1/8-3/8	
FINE SAND				12		20		11. Static water level: <input type="checkbox"/> mo./day/yr. 10 ft. below land surface Date 5 5 79	
CLAY				20		30		12. Pumping level below land surfaces: <input type="checkbox"/> ft. after <input type="checkbox"/> hrs. pumping <input type="checkbox"/> g.p.m. <input type="checkbox"/> ft. after <input type="checkbox"/> hrs. pumping <input type="checkbox"/> g.p.m. Estimated maximum yield 207 g.p.m.	
FINE / MED SAND				30		40		13. Water sample submitted: <input type="checkbox"/> mo./day/yr. <input type="checkbox"/> Yes <input checked="" type="checkbox"/> No Date <input type="checkbox"/>	
COURSE SAND				40		46		14. Well head completion: <input type="checkbox"/> Pitless adapter 12 Inches above grade	
RED BED				46				15. Well grouted? <input checked="" type="checkbox"/> With: <input type="checkbox"/> Neat cement <input type="checkbox"/> Bentonite <input checked="" type="checkbox"/> Concrete Depth: From 0 ft. to 10 ft.	
								16. Nearest source of possible contamination: ft. 40 Direction S Type SEWER Well disinfected upon completion? <input checked="" type="checkbox"/> Yes <input type="checkbox"/> No	
								17. Pump: <input type="checkbox"/> Not installed Manufacturer's name STA-RITE Model number 20P4C02HP 1/2 Volts US Length of drop pipe 40 ft. capacity 20 g.p.m. Type: <input checked="" type="checkbox"/> Submersible <input type="checkbox"/> Turbine <input type="checkbox"/> Jet <input type="checkbox"/> Reciprocating <input type="checkbox"/> Centrifugal <input type="checkbox"/> Other	
(Use a second sheet if needed)									
18. Elevation: Topography: <input type="checkbox"/> Hill <input type="checkbox"/> Slope <input type="checkbox"/> Upland <input checked="" type="checkbox"/> Valley		19. Remarks:		20. Water well contractor's certification: This well was drilled under my jurisdiction and this report is true to the best of my knowledge and belief. SOUTH CENTRAL IRR. 355 Business name License No. Address 635 So. MAIN, KINGMAN, KS. Signed Dean A. Wallace Date 7/6/79 Authorized representative					

T 28 S R 7 W 1/4 S E NE NW
 28-70-5 SE NE NW