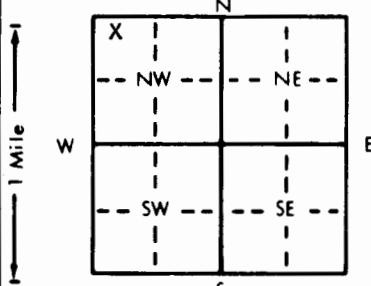


1 LOCATION OF WATER WELL: County: **Kingman** Fraction: **NW 1/4 NW 1/4 NW 1/4** Section Number: **5** Township Number: **T 28 S** Range Number: **R 7 E(W)**

Distance and direction from nearest town or city street address of well if located within city?
410 N. Main, Kingman, Kansas 67068 HWST Job No.: **74-40/4030.01**

2 WATER WELL OWNER: **Kingman Savings & Loan Association**
 RR#, St. Address, Box #: **410 N. Main** Board of Agriculture, Division of Water Resources
 City, State, ZIP Code: **Kingman, Kansas 67068** Application Number:

3 LOCATE WELL'S LOCATION WITH AN "X" IN SECTION BOX:

 4 DEPTH OF COMPLETED WELL: **35.0** ft. ELEVATION: **Unknown**
 Depth(s) Groundwater Encountered 1. **22.0** ft. 2. _____ ft. 3. _____ ft.
 WELL'S STATIC WATER LEVEL **18.4** ft. below land surface measured on **mo/day/yr 10/18/90**
 Pump test data: Well water was _____ ft. after _____ hours pumping _____ gpm
 Est. Yield _____ gpm: Well water was _____ ft. after _____ hours pumping _____ gpm
 Bore Hole Diameter **6.5** in. to **35.0** ft., and _____ in. to _____ ft.
 WELL WATER TO BE USED AS:
 5 Public water supply 8 Air conditioning 11 Injection well
 1 Domestic 3 Feedlot 6 Oil field water supply 9 Dewatering 12 Other (Specify below)
 2 Irrigation 4 Industrial 7 Lawn and garden only **1X Monitoring well MW-1**
 Was a chemical/bacteriological sample submitted to Department? Yes _____ No **X**; If yes, mo/day/yr sample was submitted _____
 Water Well Disinfected? Yes _____ No **X**

5 TYPE OF BLANK CASING USED:
 1 Steel 3 RMP (SR) 5 Wrought iron 8 Concrete tile CASING JOINTS: Glued _____ Clamped _____
 X PVC 4 ABS 6 Asbestos-Cement 9 Other (specify below) Welded _____
 7 Fiberglass _____ Threaded **X**
 Blank casing diameter **2.0** in. to **15.0** ft., Dia _____ in. to _____ ft., Dia _____ in. to _____ ft.
 Casing height above land surface **flush** in., weight _____ lbs./ft. Wall thickness or gauge No. **Sch. 40**
 TYPE OF SCREEN OR PERFORATION MATERIAL:
 1 Steel 3 Stainless steel 5 Fiberglass X PVC 10 Asbestos-cement
 2 Brass 4 Galvanized steel 6 Concrete tile 8 RMP (SR) 11 Other (specify) _____
 9 ABS 12 None used (open hole)
 SCREEN OR PERFORATION OPENINGS ARE:
 1 Continuous slot 3 Mill slot 5 Gauzed wrapped 8 Saw cut 11 None (open hole)
 2 Louvered shutter 4 Key punched 6 Wire wrapped 9 Drilled holes
 7 Torch cut 10 Other (specify) _____
 SCREEN-PERFORATED INTERVALS: From **15.0** ft. to **35.0** ft., From _____ ft. to _____ ft.
 From _____ ft. to _____ ft., From _____ ft. to _____ ft.
 GRAVEL PACK INTERVALS: From **10.0** ft. to **35.0** ft., From _____ ft. to _____ ft.
 From _____ ft. to _____ ft., From _____ ft. to _____ ft.

6 GROUT MATERIAL: 1 Neat cement 2 Cement grout X Bentonite 4 Other _____
 Grout Intervals: From **0** ft. to **10** ft., From _____ ft. to _____ ft., From _____ ft. to _____ ft.
 What is the nearest source of possible contamination:
 1 Septic tank 4 Lateral lines 7 Pit privy 10 Livestock pens 14 Abandoned water well
 2 Sewer lines 5 Cess pool 8 Sewage lagoon 11 Fuel storage 15 Oil well/Gas well
 3 Watertight sewer lines 6 Seepage pit 9 Feedyard 12 Fertilizer storage 1X Other (specify below)
 _____ **Backfilled UST pit**
 Direction from well? **East** How many feet? **20.0**

FROM	TO	LITHOLOGIC LOG	FROM	TO	PLUGGING INTERVALS
0.0	2.0	Fill Material			
2.0	10.0	Sandy Silt: brown, slightly clayey, 10-20% very fine sand, becomes red at 5'			
10.0	27.5	Sandy Clay: brown & red, 10-20% very fine sand			
27.5	35.0	Siltstone: red			

7 CONTRACTOR'S OR LANDOWNER'S CERTIFICATION: This water well was (X) constructed, (2) reconstructed, or (3) plugged under my jurisdiction and was completed on (mo/day/year) **9-27-90** and this record is true to the best of my knowledge and belief. Kansas Water Well Contractor's License No. **471** This Water Well Record was completed on (mo/day/yr) **10-22-90** under the business name of **HWS Technologies, Inc.** by (signature) *[Signature]*