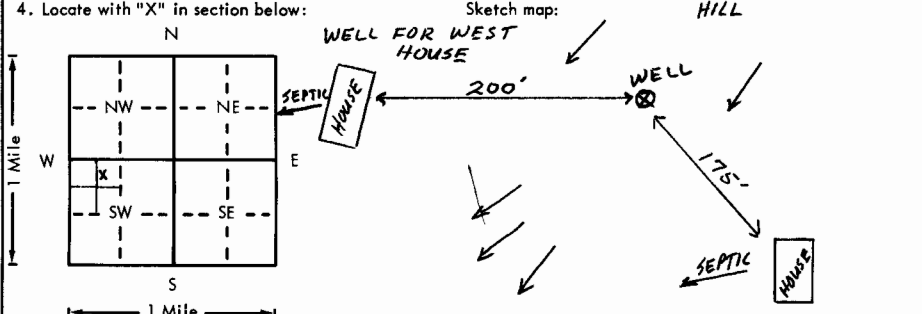


USE TYPEWRITER OR BALL
POINT PEN-PRESS FIRMLY,
PRINT CLEARLY.

WATER WELL RECORD
KSA 82a-1201-1215

Kansas Department of Health and
Environment-Division of Environment
(Water well Contractors)
Topeka, Kansas 66620

1. Location of well:		County KINGMAN	Fraction NE 1/4 NW 1/4 SW 1/4	Section number 8	Township number T 28 S R 7 EW	Range number 7 EW
2. Distance and direction from nearest town or city: 1/4 MILE SOUTH OF KINGMAN		3. Owner of well: JAKE KLAUER R.R. or street: RR-3 City, state, zip code: KINGMAN, KS. 67068				
4. Locate with "X" in section below: 		6. Bore hole dia. 10 in. Completion date 6/11/79 Well depth 28 ft.				
5. Type and color of material		7. <input checked="" type="checkbox"/> Cable tool <input checked="" type="checkbox"/> Rotary <input type="checkbox"/> Driven <input type="checkbox"/> Dug <input type="checkbox"/> Hollow rod <input type="checkbox"/> Jetted <input type="checkbox"/> Bored <input type="checkbox"/> Reverse rotary				
Top Soil		8. Use: <input checked="" type="checkbox"/> Domestic <input type="checkbox"/> Public supply <input type="checkbox"/> Industry <input type="checkbox"/> Irrigation <input type="checkbox"/> Air conditioning <input type="checkbox"/> Stock <input type="checkbox"/> Lawn <input type="checkbox"/> Oil field water <input type="checkbox"/> Other				
FINE SAND		9. Casing: Material PLASTIC Height: Above or below Threaded <input type="checkbox"/> Welded BLUE Surface 12 in. RMP PVC SCH 40 Weight 2.827 lbs./ft. Dia. 5 in. to 14 ft. depth Wall Thickness: inches or Dia. <input type="checkbox"/> in. to <input type="checkbox"/> ft. depth gage No. .258				
CLAY		10. Screen: Manufacturer's name PUMPCO Type PVC Dia. 5" Slot/gauze .030 Length 14' Set between 14 ft. and 28 ft. Gravel pack? <input checked="" type="checkbox"/> Size range of material 1/8-3/8				
FINE - MED SAND		11. Static water level: <input type="checkbox"/> mo./day/yr. 13 ft. below land surface Date 6 1 79				
COURSE SAND		12. Pumping level below land surfaces: 17 ft. after 3 hrs. pumping 18 g.p.m. ft. after <input type="checkbox"/> hrs. pumping <input type="checkbox"/> g.p.m. Estimated maximum yield 18 g.p.m.				
RED BED		13. Water sample submitted: <input type="checkbox"/> mo./day/yr. Yes <input checked="" type="checkbox"/> No <input type="checkbox"/> Date <input type="checkbox"/>				
		14. Well head completion: <input checked="" type="checkbox"/> Pitless adapter <input type="checkbox"/> Inches above grade				
		15. Well grouted? <input checked="" type="checkbox"/> With: <input type="checkbox"/> Neat cement <input type="checkbox"/> Bentonite <input checked="" type="checkbox"/> Concrete Depth: From 4 ft. to 14 ft.				
		16. Nearest source of possible contamination: ft. 175 Direction SOUTH Type SEPTIC Well disinfected upon completion? <input checked="" type="checkbox"/> Yes <input type="checkbox"/> No				
		17. Pump: Not installed Manufacturer's name STA-RITE Model number 8P480L HP 1/3 Volts 230 Length of drop pipe 24 ft. capacity 10 g.p.m. Type: <input checked="" type="checkbox"/> Submersible <input type="checkbox"/> Turbine <input type="checkbox"/> Jet <input type="checkbox"/> Reciprocating <input type="checkbox"/> Centrifugal <input type="checkbox"/> Other				
18. Elevation:		20. Water well contractor's certification: This well was drilled under my jurisdiction and this report is true to the best of my knowledge and belief. SOUTH CENTRAL IRR. 355 Business name License No. Address 635 SO. MAIN, KINGMAN, KS. Signed Dean K. Wallace Date 6/11/79 Authorized representative				
19. Remarks: Topography: <input type="checkbox"/> Hill <input checked="" type="checkbox"/> Slope <input checked="" type="checkbox"/> Upland <input type="checkbox"/> Valley						