

1	LOCATION OF WATER WELL:	Fraction	Section Number	Township Number	Range Number
	County: <u>Kingman</u>	<u>NW</u> $\frac{1}{4}$ <u>SW</u> $\frac{1}{4}$ <u>SW</u> $\frac{1}{4}$	<u>8</u>	<u>T 28 S</u>	<u>R 7</u> NW

Distance and direction from nearest town or city street address of well if located within city?

3/4 Mi. south, 1/4 mi West of Kingman, Kans

2] WATER WELL OWNER: Marvin Miller

RR#, St. Address, Box # : RT#1

Board of Agriculture, Division of Water Resources


City, State, ZIP Code : Rago, Kansas 67128

Application Number:

3 LOCATE WELL'S LOCATION WITH AN "X" IN SECTION BOX:

4 DEPTH OF COMPLETED WELL 42'

ft. ELEVATION: 1141'

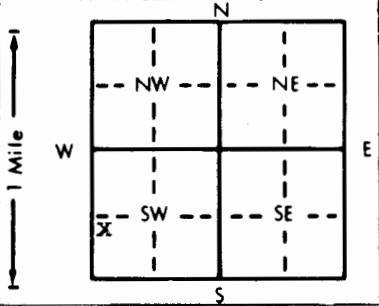

Depth(s) Groundwater Encountered 1. 4' ft. 2. ft. 3. ft.

WELL'S STATIC WATER LEVEL 14' ft. below land surface measured on mo/day/yr Sept 11 -92

Pump test data: Well water was NA ft. after hours pumping gpm

Est. Yield 12 gpm: Well water was ft. after hours pumping gpm

Bore Hole Diameter 7 7/8" in. to 42' ft., and in. to ft.

WELL WATER TO BE USED AS:

5 Public water supply	8 Air conditioning	11 Injection well
XX Domestic	3 Feedlot	6 Oil field water supply
	9 Dewatering	12 Other (Specify below)
2 Irrigation	4 Industrial	7 Lawn and garden only
	10 Monitoring well	

Was a chemical/bacteriological sample submitted to Department? Yes No X; If yes, mo/day/yr sample was submitted

Water Well Disinfected? Yes X No

5 TYPE OF BLANK CASING USED:

5 Wrought iron 8 Concrete tile CASING JOINTS: Glued **X** Clamped

1 Steel 3 RMP (SR) 6 Asbestos-Cement 9 Other (specify below) Welded
 XX 2 PVC 4 ABS 7 Fiberglass Threaded
 Blank casing diameter 5 in. to 28' ft. Dia. in. to ft. Dia. in. to ft.
 Casing height above land surface 14" in. weight 160 lbs./ft. Wall thickness or gauge No. SDR 26

TYPE OF SCREEN OR PERFORATION MATERIAL:

N MATERIAL:		X7 PVC	10 Asbestos-cement
s steel	5 Fiberglass	8 RMP (SR)	11 Other (specify)
zed steel	6 Concrete tile	9 ABS	12 None used (open hole)

SCREEN OR PERFORATION OPENINGS ARE:

IGS ARE:	5 Gauzed wrapped	XXB Saw cut	11 None (open hole)
mill slot	6 Wire wrapped	9 Drilled holes	
ey punched	7 Torch cut	10 Other (specify)	

SCREEN-PERFORATED INTERVALS: From 28' ft. to 42' ft. From ft. to ft.
From ft. to ft. From ft. to ft.
GRAVEL PACK INTERVALS: From ft. to ft. From ft. to ft.
From 42' ft. to 23' ft. From ft. to ft.

6	GROUT MATERIAL:	1 Neat cement	2 Cement grout	XX 3 Bentonite	4 Other
---	-----------------	---------------	----------------	----------------	---------------

Grout Intervals: From 23 ft. to 4' ft., From _____ ft. to _____ ft., From _____ ft. to _____ ft.

What is the nearest source of possible contamination:

contamination:		XX 10 Livestock pens	14 Abandoned water well
ral lines	7 Pit privy	11 Fuel storage	15 Oil well/Gas well
s pool	8 Sewage lagoon	12 Fertilizer storage	16 Other (specify below)
age pit	9 Feedyard	13 Insecticide storage	

Direction from well?

SOUTH EAST

How many feet? APP . 1200'

[illegible]

7 CONTRACTOR'S OR LANDOWNER'S CERTIFICATION: This water well was (1) constructed, (2) reconstructed, or (3) plugged under my jurisdiction and was completed on (mo/day/year) Sept 11-92 and this record is true to the best of my knowledge and belief. Kansas Water Well Contractor's License No. 112 This Water Well Record was completed on (mo/day/yr) OCT 5 92 under the business name of Wells Drilling Co. by (signature) Wes Wells