WATER WELL RECORD Form WWC-5 KSA 82a-1212

1 LOCATION OF WATER WELL: County: Kingman | Fraction: ne ¼ ne ¼ ne ¼ | Section Number: ~~16~~ 18 | Township Number: T 28 S | Range Number: R 7 W ~~E~~W

Distance and direction from nearest town or city street address of well if located within city?
5½ miles east of Kingman on 8th st.

2 WATER WELL OWNER: Don Dye
RR#, St. Address, Box # : RT#1
City, State, ZIP Code : Kingman, Kans. 67068

Board of Agriculture, Division of Water Resources
Application Number:

3 LOCATE WELL'S LOCATION WITH AN "X" IN SECTION BOX:

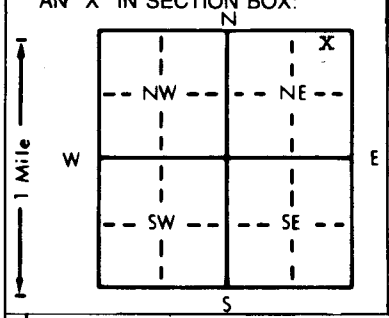

4 DEPTH OF COMPLETED WELL 50' ft. ELEVATION:
Depth(s) Groundwater Encountered 1. 17' ft. 2. ft. 3. ft.
WELL'S STATIC WATER LEVEL 16' ft. below land surface measured on mo/day/yr Jan 22, 90
Pump test data: Well water was NA ft. after hours pumping gpm
Est. Yield gpm: Well water was ft. after hours pumping gpm
Bore Hole Diameter 7 7/8" in. to 50' ft., and in. to ft.
WELL WATER TO BE USED AS: 5 Public water supply 8 Air conditioning 11 Injection well
XX 1 Domestic 3 Feedlot 6 Oil field water supply 9 Dewatering 12 Other (Specify below)
2 Irrigation 4 Industrial 7 Lawn and garden only 10 Monitoring well
Was a chemical/bacteriological sample submitted to Department? Yes No X; If yes, mo/day/yr sample was submitted
Water Well Disinfected? Yes XX No

5 TYPE OF BLANK CASING USED: 5 Wrought iron 8 Concrete tile CASING JOINTS: Glued XX Clamped
1 Steel 3 RMP (SR) 6 Asbestos-Cement 9 Other (specify below) Welded
2 PVC XX 4 ABS 7 Fiberglass Threaded
Blank casing diameter 5" in. to 17' ft., Dia in. to ft., Dia in. to ft.
Casing height above land surface 18" in., weight 160 lbs./ft. Wall thickness or gauge No. sdr 26
TYPE OF SCREEN OR PERFORATION MATERIAL: 7 PVC XX 10 Asbestos-cement
1 Steel 3 Stainless steel 5 Fiberglass 8 RMP (SR) 11 Other (specify)
2 Brass 4 Galvanized steel 6 Concrete tile 9 ABS 12 None used (open hole)
SCREEN OR PERFORATION OPENINGS ARE: 5 Gauzed wrapped XX 8 Saw cut 11 None (open hole)
1 Continuous slot 3 Mill slot 6 Wire wrapped 9 Drilled holes
2 Louvered shutter 4 Key punched 7 Torch cut 10 Other (specify)
SCREEN-PERFORATED INTERVALS: From 17' ft. to 50' ft., From ft. to ft.
From ft. to ft., From ft. to ft.
GRAVEL PACK INTERVALS: From ft. to ft., From ft. to ft.
From 50' ft. to 15' ft., From ft. to ft.

6 GROUT MATERIAL: 1 Neat cement XX 2 Cement grout ~~XX~~ 3 Bentonite 4 Other
Grout Intervals: From 15' ft. to 0' ft., From ft. to ft., From ft. to ft.
What is the nearest source of possible contamination: XX 10 Livestock pens 14 Abandoned water well
1 Septic tank 4 Lateral lines 7 Pit privy 11 Fuel storage 15 Oil well/Gas well
2 Sewer lines 5 Cess pool 8 Sewage lagoon 12 Fertilizer storage 16 Other (specify below)
3 Watertight sewer lines 6 Seepage pit 9 Feedyard 13 Insecticide storage
Direction from well? East How many feet? 350'

FROM	TO	LITHOLOGIC LOG	FROM	TO	PLUGGING INTERVALS
0'	3'	top soil			
3'	17'	red bed			
17'	26'	Broken red bed			
26'	44'	red bed			
44'	50'	Broken red bed			

7 CONTRACTOR'S OR LANDOWNER'S CERTIFICATION: This water well was (1) constructed, (2) reconstructed, or (3) plugged under my jurisdiction and was completed on (mo/day/year) Jan 22 1990 and this record is true to the best of my knowledge and belief. Kansas Water Well Contractor's License No. 112 This Water Well Record was completed on (mo/day/yr) Mar 23 90
under the business name of Wells Drilling Co. by (signature) Dal Wells

INSTRUCTIONS: Use typewriter or ball point pen. *PLEASE PRESS FIRMLY* and *PRINT* clearly. Please fill in blanks, underline or circle the correct answers. Send top three copies to Kansas Department of Health and Environment, Bureau of Water, Topeka, Kansas 66620-7320. Telephone: 913-296-5545. Send one to WATER WELL OWNER and retain one for your records.

OFFICE USE ONLY
T
R
E/W
SEC.
¼
¼
¼