


1 LOCATION OF WATER WELL: Fraction NE 1/4 NW 1/4 NW 1/4 Section Number 25 Township Number T 28 S Range Number R 7 E/W
 County: Kingman

Distance and direction from nearest town or city street address of well if located within city?
4 miles south 5 east of Kingman, Kns.

2 WATER WELL OWNER: Elma Strausz
 RR#, St. Address, Box #: 536 west H. Board of Agriculture, Division of Water Resources
 City, State, ZIP Code: Kingman, Kans Application Number:

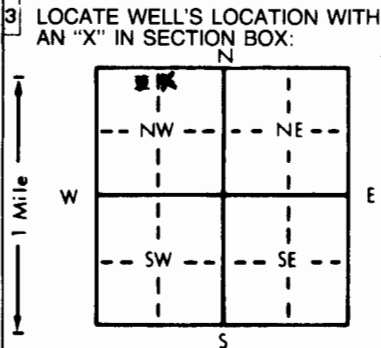

4 DEPTH OF COMPLETED WELL: 52' ft. ELEVATION: ft.
 Depth(s) Groundwater Encountered 1. 28 ft. 2. ft. 3. ft.
 WELL'S STATIC WATER LEVEL 27 ft. below land surface measured on mo/day/yr Sept. 14. 92
 Pump test data: Well water was NA ft. after hours pumping gpm
 Est. Yield 1.5 gpm: Well water was NA ft. after hours pumping gpm
 Bore Hole Diameter: 7 7/8 in. to 52' ft., and in. to ft.
 WELL WATER TO BE USED AS:
 5 Public water supply 8 Air conditioning 11 Injection well
 X1 Domestic 3 Feedlot 6 Oil field water supply 9 Dewatering 12 Other (Specify below)
 2 Irrigation 4 Industrial 7 Lawn and garden only 10 Monitoring well
 Was a chemical/bacteriological sample submitted to Department? Yes.....No...X...; If yes, mo/day/yr sample was submitted
 Water Well Disinfected? Yes X No

5 TYPE OF BLANK CASING USED:
 1 Steel 3 RMP (SR) 5 Wrought iron 8 Concrete tile CASING JOINTS: Glued XX Clamped
 XX2 PVC 4 ABS 6 Asbestos-Cement 9 Other (specify below) Welded
 7 Fiberglass Threaded.....
 Blank casing diameter 5 in. to 44 ft., Dia in. to ft., Dia in. to ft.
 Casing height above land surface 16" in., weight 160 lbs./ft. Wall thickness or gauge No. Sdr. 26
 TYPE OF SCREEN OR PERFORATION MATERIAL: XX PVC 10 Asbestos-cement
 1 Steel 3 Stainless steel 5 Fiberglass 8 RMP (SR) 11 Other (specify)
 2 Brass 4 Galvanized steel 6 Concrete tile 9 ABS 12 None used (open hole)
 SCREEN OR PERFORATION OPENINGS ARE:
 5 Gauzed wrapped XX Saw cut 11 None (open hole)
 1 Continuous slot 3 Mill slot 6 Wire wrapped 9 Drilled holes
 2 Louvered shutter 4 Key punched 7 Torch cut 10 Other (specify)
 SCREEN-PERFORATED INTERVALS: From 52' ft. to 44' ft., From ft. to ft.
 From ft. to ft., From ft. to ft.
 GRAVEL PACK INTERVALS: From ft. to ft., From ft. to ft.
 From 52' ft. to 21' ft., From ft. to ft.

6 GROUT MATERIAL: 1 Neat cement 2 Cement grout XX Bentonite 4 Other
 Grout intervals: From 21' ft. to 2' ft., From ft. to ft., From ft. to ft.
 What is the nearest source of possible contamination:
 1 Septic tank 4 Lateral lines 7 Pit privy XX 10 Livestock pens 14 Abandoned water well
 2 Sewer lines 5 Cess pool 8 Sewage lagoon 11 Fuel storage 15 Oil well/Gas well
 3 Watertight sewer lines 6 Seepage pit 9 Feedyard 12 Fertilizer storage 16 Other (specify below)
 13 Insecticide storage
 Direction from well? West How many feet? 90'

FROM	TO	LITHOLOGIC LOG	FROM	TO	PLUGGING INTERVALS
0'	4'	Top soil			
4'	9'	clay.			
9'	16'	Brown clay.			
16'	27'	Sandy clay.			
27'	34'	sandy clay.			
34'	37'	Fine sand.			
37'	41'	clay.			
41'	50'	course sand.			
50'	52'	Red bed.			

7 CONTRACTOR'S OR LANDOWNER'S CERTIFICATION: This water well was (1) constructed, (2) reconstructed, or (3) plugged under my jurisdiction and was completed on (mo/day/year) Sept. 14. - 92 and this record is true to the best of my knowledge and belief. Kansas Water Well Contractor's License No. 112 This Water Well Record was completed on (mo/day/yr) Oct. 5. - 92 under the business name of Wells Drilling co. by (signature) Dal Wells

INSTRUCTIONS: Use typewriter or ball point pen. PLEASE PRESS FIRMLY and PRINT clearly. Please fill in blanks, underline or circle the correct answers. Send top three copies to Kansas Department of Health and Environment, Bureau of Water, Topeka, Kansas 66620-0001. Telephone: 913-296-5545. Send one to WATER WELL OWNER and retain one for your records.