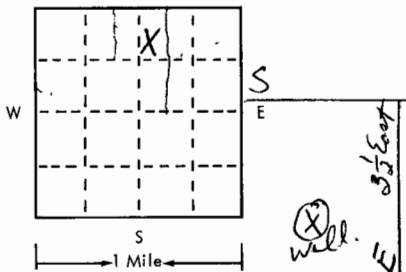


USE TYPEWRITER OR BALL POINT PEN-PRESS FIRMLY, PRINT CLEARLY.

T R EW sec 1/4 1/4 1/4 No.

WATER WELL RECORD
KSA 82a-1201-1215

Kansas State Dept. Of Health
(Water Well Contractors)
Forbes-Bldg. 740
Topeka, Kansas 66620

1 Location of well:	County <i>Kingman</i>	Township name <i>East MINNESCHA</i>	Fraction <i>NW 1/4</i>	Section number <i>26</i>	Town number <i>28</i>	Range number <i>7</i>
Distance and direction from nearest town or city: <i>4 South 3 1/2 East</i> Street address of well location if in city: <i>Kingman Kansas</i>				3 Owner of well: <i>HOWARD WALLACE</i> Address: <i>ELLENWOOD KANSAS 67526</i>		
Locate with "X" in section below: N  W E S Sketch map: <i>14 HWY</i> <i>Kingman Kan</i>				4 Well depth: <i>45</i> ft. Date of completion <i>6-5-75</i> Well diameter <i>8</i> in. <i>is Bare Hole</i>		
2 Type and color of material				5 <input type="checkbox"/> Cable tool <input checked="" type="checkbox"/> Rotary <input type="checkbox"/> Driven <input type="checkbox"/> Dug <input type="checkbox"/> Hollow rod <input type="checkbox"/> Jetted <input type="checkbox"/> Bored <input type="checkbox"/> Reverse rotary		
				6 Use: <input checked="" type="checkbox"/> Domestic <input type="checkbox"/> Public supply <input type="checkbox"/> Industry <input type="checkbox"/> Irrigation <input type="checkbox"/> Air conditioning <input type="checkbox"/> Commercial <input type="checkbox"/> Test well <input checked="" type="checkbox"/> <i>and Stock</i>		
From To				7 Casing: Material <i>PIPE</i> Height: <i>above/below</i> Threaded <input type="checkbox"/> Welded <input type="checkbox"/> Surface <i>24</i> in. Diam. <i>5</i> in. to <i>45</i> ft. depth Drive shoe? <input type="checkbox"/> Yes <input checked="" type="checkbox"/> No <i>5</i> in. to <i>—</i> ft. depth		
				8 Screen: Manufacturer <i>Jess & Lowell</i> Type <i>Pve</i> Dia. <i>5</i> Slot/gauze <i>1/16</i> Length <i>10</i> Set between <i>35</i> ft. and <i>45</i> ft. Fittings: Gravel pack <input checked="" type="checkbox"/> Yes <input type="checkbox"/> No Size range of material <i>4</i>		
Sail Sand Brown Sand and clay Ground water Sand TOTAL Depth 45' feet				9 Static water level: <i>20</i> ft. below land surface Date <i>6-5-75</i>		
				10 Pumping level below land surfaces: <i>—</i> ft. after <i>—</i> hrs. pumping <i>—</i> g.p.m. <i>—</i> ft. after <i>1 1/2</i> hrs. pumping <i>—</i> g.p.m. Estimated maximum yield <i>—</i> g.p.m.		
				11 Water sample submitted: <input type="checkbox"/> Yes <input checked="" type="checkbox"/> No Date <i>6-5-75</i>		
				12 Well head completion: <input type="checkbox"/> Pitless adapter <input type="checkbox"/> Inches above grade		
				13 Well grouted? <input checked="" type="checkbox"/> Yes <input type="checkbox"/> No <input checked="" type="checkbox"/> Neat cement <input type="checkbox"/> Bentonite <input type="checkbox"/> <i>—</i> Depth: From <i>1</i> ft. to <i>10</i> ft.		
				14 Nearest source of possible contamination: <i>NONE Pasture</i> ft. <i>—</i> Direction <i>—</i> Type <i>—</i> Well disinfected upon completion? <input checked="" type="checkbox"/> Yes <input type="checkbox"/> No		
(use a second sheet if needed)				15 Pump: <input type="checkbox"/> Not installed Manufacturer's name <i>DEMISTER MILK</i> Model number <i>6/24</i> HP <i>—</i> Volts <i>—</i> Length of drop pipe <i>32</i> ft. capacity <i>—</i> g.m.p. Type: <input type="checkbox"/> Submersible <input type="checkbox"/> Turbine <input type="checkbox"/> Jet <input checked="" type="checkbox"/> Reciprocating <input type="checkbox"/> Centrifugal <input type="checkbox"/> Other		
				17 Water well contractor's certification: This well was drilled under my jurisdiction and this report is true to the best of my knowledge and belief. <i>WEBER WELL SERVICE 226</i> Business name <i>NASHVILLE & KANSAS</i> License No. <i>—</i> Address <i>SEAN GULBA</i> Date <i>5-6-75</i> Signed <i>—</i> Authorized representative		
16 Remarks: elevation						
Topography: <input type="checkbox"/> Hill <input checked="" type="checkbox"/> Slope <input type="checkbox"/> Upland <input type="checkbox"/> Valley						