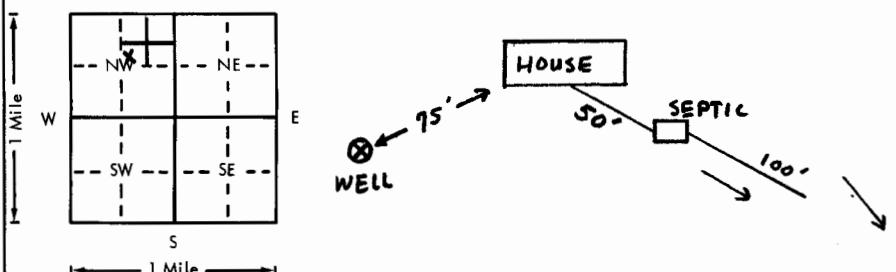


USE TYPEWRITER OR BALL
POINT PEN-PRESS FIRMLY,
PRINT CLEARLY.

WATER WELL RECORD
KSA 82a-1201-1215

Kansas Department of Health and
Environment-Division of Environment
(Water well Contractors)
Topeka, Kansas 66620

1. Location of well:		County KINGMAN	Fraction SW 1/4 NE 1/4 NW 1/4	Section number 29	Township number T 28	Range number S R 7	E/W
2. Distance and direction from nearest town or city: 2 1/2 MILE Street address of well location if in city: SOUTH OF KINGMAN				3. Owner of well: GEO. TATRO R.R. or street: RR 3 City, state, zip code: KINGMAN, KS 67068			
4. Locate with "X" in section below:		Sketch map:		6. Bore hole dia. 10 in. Completion date 5/11/79 Well depth 40 ft.			
				7. <input checked="" type="checkbox"/> Cable tool <input checked="" type="checkbox"/> Rotary <input type="checkbox"/> Driven <input type="checkbox"/> Dug <input type="checkbox"/> Hollow rod <input type="checkbox"/> Jetted <input type="checkbox"/> Bored <input type="checkbox"/> Reverse rotary			
5. Type and color of material				8. Use: <input checked="" type="checkbox"/> Domestic <input type="checkbox"/> Public supply <input type="checkbox"/> Industry <input type="checkbox"/> Irrigation <input type="checkbox"/> Air conditioning <input type="checkbox"/> Stock <input type="checkbox"/> Lawn <input type="checkbox"/> Oil field water <input type="checkbox"/> Other			
TOP SOIL		From 0 To 2		9. Casing: Material PVC Height: Above or below Threaded <input type="checkbox"/> Welded <input checked="" type="checkbox"/> Surface 12 in. RMP PVC GLUE Weight 2.827 lbs./ft. Dia. 5 in. to 20 ft. depth Wall Thickness: inches or Dia. 5 in. to 20 ft. depth Gauge No. .258			
CLAY		From 2 To 8		10. Screen: Manufacturer's name PUMPCO Type PVC Dia. 5" Slot/gauze .030 Length 20' Set between 20 ft. and 40 ft. ft. and 40 ft. Gravel pack? <input checked="" type="checkbox"/> Size range of material 1/8-3/8			
FINE SAND		From 8 To 20		11. Static water level: 10 ft. below land surface Date 4/15/79			
MED-COURSE SAND		From 20 To 40		12. Pumping level below land surfaces: 12 ft. after 1 hrs. pumping 60 g.p.m. ft. after 1 hrs. pumping 60 g.p.m. Estimated maximum yield 100 g.p.m.			
TERMINATED BORE HOLE		From 40 To		13. Water sample submitted: X Yes <input checked="" type="checkbox"/> No Date			
				14. Well head completion: <input checked="" type="checkbox"/> Pitless adapter <input type="checkbox"/> Inches above grade			
				15. Well grouted? <input checked="" type="checkbox"/> With: <input type="checkbox"/> Neat cement <input type="checkbox"/> Bentonite <input checked="" type="checkbox"/> Concrete Depth: From 4 ft. to 14 ft.			
				16. Nearest source of possible contamination: ft. 125 Direction EAST Type SEPTIC Well disinfected upon completion? <input checked="" type="checkbox"/> Yes <input type="checkbox"/> No			
				17. Pump: <input type="checkbox"/> Not installed Manufacturer's name STA-RITE Model number 20PYEDL HP 1 Volts 230 Length of drop pipe 30 ft. capacity 30 g.p.m. Type: <input checked="" type="checkbox"/> Submersible <input type="checkbox"/> Turbine <input type="checkbox"/> Jet <input type="checkbox"/> Reciprocating <input type="checkbox"/> Centrifugal <input type="checkbox"/> Other			
				20. Water well contractor's certification: This well was drilled under my jurisdiction and this report is true to the best of my knowledge and belief. SOUTH CENTRAL IRR. 355 Business name License No. Address 635 S. MAIN Signed Dean K. Wallace Date 6/9/79 Authorized representative			
18. Elevation:		19. Remarks:					
Topography: <input type="checkbox"/> Hill <input type="checkbox"/> Slope <input checked="" type="checkbox"/> Upland <input type="checkbox"/> Valley							

287-29
SUNFNU
1/4 1/4 1/4 1/4