


1 LOCATION OF WATER WELL: County: <u>Kingman</u>	Fraction <u>SE 1/4 NW 1/4 NE 1/4</u>	Section Number <u>23</u>	Township Number <u>28 S</u>	Range Number <u>7 E</u> W
--	---	-----------------------------	--------------------------------	--

Distance and direction from nearest town or city street address of well if located within city?
From Kingman, KS 90 3 miles South & 3 miles East
And SE to well

2 WATER WELL OWNER: <u>James Mann</u> RR#, St. Address, Box #: <u>P.O. Box 770165</u> City, State ZIP Code: <u>Steamboat Springs CO. 80477</u>	Global Positioning Systems (decimal degrees, min. of 4 digits) Latitude: _____ Longitude: _____ Elevation: _____ Datum: _____ Data Collection Method: _____
---	---

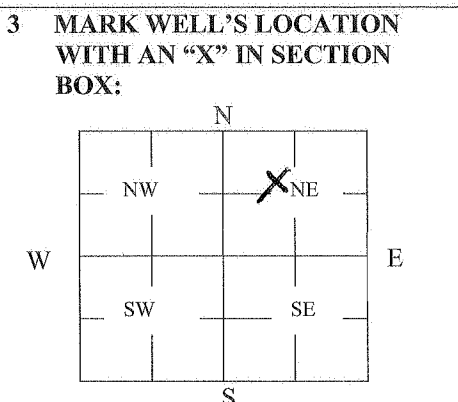

4 DEPTH OF WELL 35 ft.
WELL'S STATIC WATER LEVEL 6 ft.
WELL WAS USED AS:
 1 Domestic 5 Public Water Supply 9 Dewatering
 2 Irrigation 6 Oil Field Water Supply 10 Monitoring
 3 Feedlot 7 Domestic (Lawn & Garden) 11 Injection Well
 4 Industrial 8 Air Conditioning 12 Other _____
 Was a chemical/bacteriological sample submitted to Department? Yes _____ No

5 TYPE OF BLANK CASING USED:
 1 Steel 3 RMP (SR) 5 Wrought 7 Fiberglass 9 Other (Specify below) _____
 2 PVC 4 ABS 6 Asbestos-Cement 8 Concrete Tile _____
 Blank casing diameter 6 in. Was casing pulled? Yes No _____ If yes, how much 3ft
 Casing height above or below land surface 36 in.

6 GROUT PLUG MATERIAL: 1 Neat cement 2 Cement grout 3 Bentonite 4 Other Clay Top Soil
 Grout Plug Intervals: From 35 ft. to 03 ft., From 3 ft. to 0 ft., From _____ to _____ ft.
 What is the nearest source of possible contamination:
 1 Septic tank 6 Seepage pit 11 Fuel Storage 16 Other (specify below) _____
 2 Sewer lines 7 Pit privy 12 Fertilizer storage _____
 3 Watertight sewer lines 8 Sewage lagoon 13 Insecticide storage _____
 4 Lateral lines 9 Feedyard 14 Abandoned water well Direction from well? 999
 5 Cess pool 10 Livestock pens 15 Oil well/Gas well How many feet? 999

FROM	TO	PLUGGING MATERIALS	FROM	TO	PLUGGING MATERIALS
<u>35</u>	<u>03</u>	<u>Bentonite Hole Plug</u>			
<u>3</u>	<u>0</u>	<u>Clay Top Soil</u>			

7 CONTRACTOR'S OR LANDOWNER'S CERTIFICATION: This water well was plugged under my jurisdiction and was completed on (mo/day/year) 2-4-14 and this record is true to the best of my knowledge and belief. Kansas Water Well Contractor's License No. 672. This Water Well Record was completed on (mo/day/year) 2-13-14 under the business name of Crowdis Water Well Serv. by (signature) [Signature]