


1 LOCATION OF WATER WELL: Fraction Section Number Township Number Range Number
 County: Kingman NE 1/4 NW 1/4 NE 1/4 32 T 28 S R 8 ~~28W~~

Distance and direction from nearest town or city street address of well if located within city?
4 miles south 1/2 west 1 mile south 4 miles west Of Kingman, Kans

2 WATER WELL OWNER: Marvin Neville
 RR#, St. Address, Box # : RT#3 - Box 97 Board of Agriculture, Division of Water Resources
 City, State, ZIP Code : Kingman, Kans. 67068 Application Number: 953011-TD

3 LOCATE WELL'S LOCATION WITH AN "X" IN SECTION BOX:

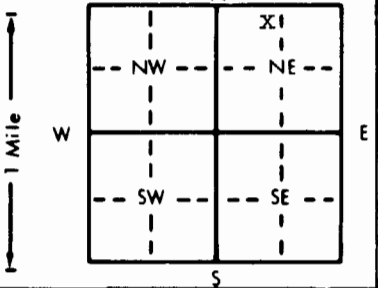

4 DEPTH OF COMPLETED WELL: 140' ft. ELEVATION: _____ ft.

Depth(s) Groundwater Encountered 1. 56. 1/2" ft. 2. _____ ft. 3. _____ ft.
 WELL'S STATIC WATER LEVEL 56. 1/2" ft. below land surface measured on mo/day/yr Sept. 12-95
 Pump test data: Well water was _____ ft. after _____ hours pumping _____ gpm
 Est. Yield 35 gpm: Well water was NA ft. after _____ hours pumping _____ gpm
 Bore Hole Diameter: 7. 7/8" in. to 140' ft., and _____ in. to _____ ft.
 WELL WATER TO BE USED AS: 5 Public water supply 8 Air conditioning 11 Injection well
 1 Domestic XX3 Feedlot 6 Oil field water supply 9 Dewatering 12 Other (Specify below)
 2 Irrigation 4 Industrial 7 Lawn and garden only 10 Monitoring well _____
 Was a chemical/bacteriological sample submitted to Department? Yes _____ No X; If yes, mo/day/yr sample was submitted
 Water Well Disinfected? Yes X No

5 TYPE OF BLANK CASING USED: 5 Wrought iron 8 Concrete tile CASING JOINTS: Glued XX Clamped
 1 Steel 3 RMP (SR) 6 Asbestos-Cement 9 Other (specify below) Welded _____
XX2 PVC 4 ABS 7 Fiberglass Threaded _____
 Blank casing diameter 5" in. to 59 ft., Dia 5" in. to 63' -128' ft., Dia _____ in. to _____ ft.
 Casing height above land surface 16" in., weight 160 lbs./ft. Wall thickness or gauge No. SDR26

TYPE OF SCREEN OR PERFORATION MATERIAL: XX 7 PVC 10 Asbestos-cement
 1 Steel 3 Stainless steel 5 Fiberglass 8 RMP (SR) 11 Other (specify) _____
 2 Brass 4 Galvanized steel 6 Concrete tile 9 ABS 12 None used (open hole)

SCREEN OR PERFORATION OPENINGS ARE: 5 Gauzed wrapped XXX 8 Saw cut 11 None (open hole)
 1 Continuous slot 3 Mill slot 6 Wire wrapped 9 Drilled holes
 2 Louvered shutter 4 Key punched 7 Torch cut 10 Other (specify) _____

SCREEN-PERFORATED INTERVALS: From 59' ft. to 63' ft., From 128' ft. to 140' ft.
 From _____ ft. to _____ ft., From _____ ft. to _____ ft.
 GRAVEL PACK INTERVALS: From _____ ft. to _____ ft., From _____ ft. to _____ ft.
 From 140' ft. to 56' ft., From _____ ft. to _____ ft.

6 GROUT MATERIAL: 1 Neat cement 2 Cement grout XX 3 Bentonite 4 Other _____
 Grout Intervals: From 56' ft. to 38' ft., From _____ ft. to 23' ft., From 2' ft. to _____ ft.

What is the nearest source of possible contamination:
 1 Septic tank 4 Lateral lines 7 Pit privy 10 Livestock pens 14 Abandoned water well
 2 Sewer lines 5 Cess pool 8 Sewage lagoon 11 Fuel storage 15 Oil well/Gas well
 3 Watertight sewer lines 6 Seepage pit XX9 Feedyard 12 Fertilizer storage 16 Other (specify below)
 13 Insecticide storage _____

Direction from well? South Westt How many feet? App: 267'

FROM	TO	LITHOLOGIC LOG	FROM	TO	PLUGGING INTERVALS
0'	3'	Top soil.			
3'	10'	Course Gravel.			
10'	28'	Sandy Clay.			
28'	59'	Brown Clay.			
59'	64' 64'	Brown Sand.			
64' 64'	120'	Grey Clay (Dark).			
120'	139'	Medium Course Gravel.			
139'	140'	Red Bed.			

7 CONTRACTOR'S OR LANDOWNER'S CERTIFICATION: This water well was (1) constructed, (2) reconstructed, or (3) plugged under my jurisdiction and was completed on (mo/day/year) Aug. 25 -95 and this record is true to the best of my knowledge and belief. Kansas Water Well Contractor's License No. 112 This Water Well Record was completed on (mo/day/yr) Sept 21-95 under the business name of Wells Drilling Co. by (signature) Hal Wells