


1 LOCATION OF WATER WELL: County: Kingman Fraction: NE 1/4 NW 1/4 NE 1/4 Section Number: 32 Township Number: T 28 S Range Number: R 8

Distance and direction from nearest town or city street address of well if located within city?  
4 Miles South 1/2 West 1 mile South 4 Miles West Of Kingman, Kans.

2 WATER WELL OWNER: Marvin Neville  
 RR#, St. Address, Box #: RR#3 - Box 97  
 City, State, ZIP Code: Kingman, Kansas 67068  
 Board of Agriculture, Division of Water Resources  
 Application Number: 953011-TD

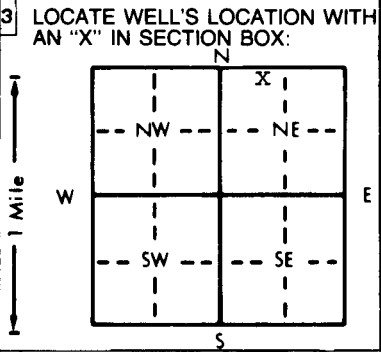

4 DEPTH OF COMPLETED WELL: 140' ft. ELEVATION: \_\_\_\_\_  
 Depth(s) Groundwater Encountered 1. 56' ft. 2. \_\_\_\_\_ ft. 3. \_\_\_\_\_ ft.  
 WELL'S STATIC WATER LEVEL 56' ft. below land surface measured on mo/day/yr Sept 18 - 95  
 Pump test data: Well water was NA ft. after \_\_\_\_\_ hours pumping \_\_\_\_\_ gpm  
 Est. Yield NA gpm; Well water was \_\_\_\_\_ ft. after \_\_\_\_\_ hours pumping \_\_\_\_\_ gpm  
 Bore Hole Diameter 6 3/4" in. to 140' ft., and \_\_\_\_\_ in. to \_\_\_\_\_ ft.  
 WELL WATER TO BE USED AS:  
 1 Domestic 3 Feedlot 6 Oil field water supply 9 Dewatering 12 Other (Specify below)  
 2 Irrigation 4 Industrial 7 Lawn and garden only 10 Monitoring well XX  
 Was a chemical/bacteriological sample submitted to Department? Yes \_\_\_\_\_ No XX; If yes, mo/day/yr sample was submitted \_\_\_\_\_  
 Water Well Disinfected? Yes X No \_\_\_\_\_

5 TYPE OF BLANK CASING USED:  
 1 Steel 3 RMP (SR) 5 Wrought iron 8 Concrete tile CASING JOINTS: Glued X Clamped \_\_\_\_\_  
X 2 PVC 4 ABS 7 Fiberglass \_\_\_\_\_ Welded \_\_\_\_\_  
 Blank casing diameter 3" in. to 93' ft., Dia. \_\_\_\_\_ in. to \_\_\_\_\_ ft., Dia. \_\_\_\_\_ in. to \_\_\_\_\_ ft.  
 Casing height above land surface 24" in., weight 1.130 lbs./ft. Wall thickness or gauge No. 26 .167  
 TYPE OF SCREEN OR PERFORATION MATERIAL:  
 1 Steel 3 Stainless steel 5 Fiberglass XX PVC 10 Asbestos-cement  
 2 Brass 4 Galvanized steel 6 Concrete tile 9 ABS 11 Other (specify) \_\_\_\_\_  
 12 None used (open hole)  
 SCREEN OR PERFORATION OPENINGS ARE:  
 1 Continuous slot 3 Mill slot 5 Gauzed wrapped 8 Saw cut XX 11 None (open hole)  
 2 Louvered shutter 4 Key punched 6 Wire wrapped 9 Drilled holes  
 7 Torch cut 10 Other (specify) \_\_\_\_\_  
 SCREEN-PERFORATED INTERVALS: From 140' ft. to 93' ft., From \_\_\_\_\_ ft. to \_\_\_\_\_ ft.  
 From \_\_\_\_\_ ft. to \_\_\_\_\_ ft., From \_\_\_\_\_ ft. to \_\_\_\_\_ ft.  
 GRAVEL PACK INTERVALS: From 140' ft. to 93' ft., From 105' ft. to \_\_\_\_\_ ft.  
 From 100' ft. to 70' ft., From \_\_\_\_\_ ft. to \_\_\_\_\_ ft.

6 GROUT MATERIAL: 1 Neat cement 2 Cement grout XX Bentonite 4 Other \_\_\_\_\_  
 Grout Intervals: From 105' ft. to 100' ft., From 70' ft. to 0' ft., From \_\_\_\_\_ ft. to \_\_\_\_\_ ft.  
 What is the nearest source of possible contamination:  
 1 Septic tank 4 Lateral lines 7 Pit privy 10 Livestock pens 14 Abandoned water well  
 2 Sewer lines 5 Cess pool 8 Sewage lagoon 11 Fuel storage 15 Oil well/Gas well  
 3 Watertight sewer lines 6 Seepage pit XX Feedyard 12 Fertilizer storage 16 Other (specify below)  
 13 Insecticide storage \_\_\_\_\_  
 Direction from well? Southwest How many feet? 250' 267'

FROM	TO	LITHOLOGIC LOG	FROM	TO	PLUGGING INTERVALS
0'	3'	Top Soil.			
3'	10'	Medium Course Sand.			
10'	19'	Course Sand & Fine Gravel.			
19'	28'	Gravel W/ Clay strips.			
28'	41'	Clay.			
41'	45'	Course sand.			
45'	65'	Course sand W/clay strips.			
65'	76'	Clay.			
76'	83'	Medium Course sand.			
83'	93'	Clay.			
93'	105'	Fine sand.			
105'	107'	Lime.			
107'	113'	Clay.			
113'	124'	Blue Clay.			
124'	140'	Course sand.			

7 CONTRACTOR'S OR LANDOWNER'S CERTIFICATION: This water well was (1) constructed, (2) reconstructed, or (3) plugged under my jurisdiction and was completed on (mo/day/year) Sept. 17 - 1995 and this record is true to the best of my knowledge and belief. Kansas Water Well Contractor's License No. 112 This Water Well Record was completed on (mo/day/yr) OCT 17 - 1995 under the business name of Wells Drilling Co. by (signature) Red Wells