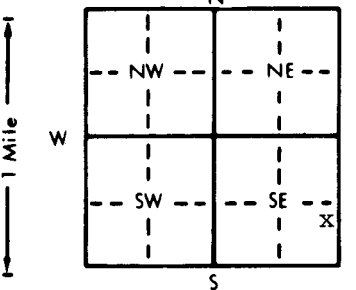


1 LOCATION OF WATER WELL:		Fraction	Section Number		Township Number		Range Number
County: Kingman		NE 1/4 SE 1/4 SE 1/4	22		T 28 S		R 8 W
Distance and direction from nearest town or city street address of well if located within city? Approximately 2 3/4 miles south and 3 1/2 miles west of Kingman							
2 WATER WELL OWNER:		City of Kingman City Hall - 324 N. Main RR#, St. Address, Box # : P.O. Box 168 City, State, ZIP Code : Kingman, KS 67068					
		Board of Agriculture, Division of Water Resources Application Number:					
3 LOCATE WELL'S LOCATION WITH AN "X" IN SECTION BOX:		4 DEPTH OF COMPLETED WELL: 107.4 ft. ELEVATION:					
		Depth(s) Groundwater Encountered 1. ft. 2. ft. 3. ft. WELL'S STATIC WATER LEVEL 28.8 ft. below land surface measured on mo/day/yr 1-11-96 Pump test data: Well water was ft. after hours pumping gpm Est. Yield gpm: Well water was ft. after hours pumping gpm Bore Hole Diameter in. to ft., and in. to ft. WELL WATER TO BE USED AS: 5 Public water supply 8 Air conditioning 11 Injection well 1 Domestic 3 Feedlot 6 Oil field water supply 9 Dewatering 12 Other (Specify below) 2 Irrigation 4 Industrial 7 Lawn and garden only 10 Monitoring well Test Well Was a chemical/bacteriological sample submitted to Department? Yes.....No.....; If yes, mo/day/yr sample was submitted Water Well Disinfected? Yes No					
5 TYPE OF BLANK CASING USED:		5 Wrought iron		8 Concrete tile		CASING JOINTS: Glued Clamped	
1 Steel		3 RMP (SR)		6 Asbestos-Cement		9 Other (specify below) Welded	
2 PVC		4 ABS		7 Fiberglass		Threaded	
Blank casing diameter 5 in. to ft., Dia in. to ft., Dia in. to ft. Casing height above land surface 5.4' below in., weight lbs./ft. Wall thickness or gauge No.							
TYPE OF SCREEN OR PERFORATION MATERIAL:				7 PVC 10 Asbestos-cement			
1 Steel 3 Stainless steel 5 Fiberglass 8 RMP (SR) 11 Other (specify)				12 None used (open hole)			
2 Brass 4 Galvanized steel 6 Concrete tile 9 ABS							
SCREEN OR PERFORATION OPENINGS ARE:				5 Gauzed wrapped 8 Saw cut 11 None (open hole)			
1 Continuous slot 3 Mill slot 6 Wire wrapped 9 Drilled holes				10 Other (specify)			
2 Louvered shutter 4 Key punched 7 Torch cut							
SCREEN-PERFORATED INTERVALS: From ft. to ft., From ft. to ft., From ft. to ft.							
GRAVEL PACK INTERVALS: From ft. to ft., From ft. to ft., From ft. to ft.							
6 GROUT MATERIAL: 1 Neat cement 2 Cement grout 3 Bentonite 4 Other Bentonite Holeplug							
Grout Intervals: From ft. to ft., From ft. to ft., From ft. to ft.				31 ft. to 4 ft.			
What is the nearest source of possible contamination:				10 Livestock pens 14 Abandoned water well			
1 Septic tank 4 Lateral lines 7 Pit privy 11 Fuel storage 15 Oil well/Gas well				12 Fertilizer storage 16 Other (specify below)			
2 Sewer lines 5 Cess pool 8 Sewage lagoon 13 Insecticide storage None known							
3 Watertight sewer lines 6 Seepage pit 9 Feedyard							
Direction from well?				How many feet?			
FROM	TO	LITHOLOGIC LOG	FROM	TO	PLUGGING INTERVALS		
			107.4	31	Chlorinated sand and gravel		
			31	4	Bentonite Holeplug		
			4	0	Fill dirt		
7 CONTRACTOR'S OR LANDOWNER'S CERTIFICATION: This water well was (1) constructed, (2) reconstructed, or (3) plugged under my jurisdiction and was completed on (mo/day/year) 1-11-96 and this record is true to the best of my knowledge and belief. Kansas Water Well Contractor's License No. 185 This Water Well Record was completed on (mo/day/yr) 1-12-96 under the business name of Clarke Well & Equipment, Inc. by (signature) 