


1 LOCATION OF WATER WELL: County: Kingman Fraction: NE 1/4 NW 1/4 NE 1/4 Section Number: 32 Township Number: T 28 S Range Number: R 8 W

Distance and direction from nearest town or city street address of well if located within city?
4 miles south, 1/2 west, 1 mile south, 4 miles west of Kingman, Kansas

2 WATER WELL OWNER: Marvin Neville
 RR#, St. Address, Box #: RT#3--Box 97
 City, State, ZIP Code: Kingman, Kans. 67068
 Board of Agriculture, Division of Water Resources
 Application Number:

3 LOCATE WELL'S LOCATION WITH AN "X" IN SECTION BOX:

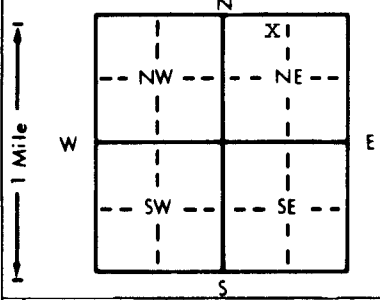

4 DEPTH OF COMPLETED WELL: 140' ft. ELEVATION:
 Depth(s) Groundwater Encountered 1. 56' ft. 2. ft. 3. ft.
 WELL'S STATIC WATER LEVEL: 56' ft. below land surface measured on mo/day/yr June 24 -96
 Pump test data: Well water was ft. after hours pumping gpm
 Est. Yield 35 gpm: Well water was NA ft. after hours pumping gpm
 Bore Hole Diameter: 10 1/4 in. to 140' ft., and in. to ft.
 WELL WATER TO BE USED AS:
 5 Public water supply 8 Air conditioning 11 Injection well
 1 Domestic Feedlot 6 Oil field water supply 9 Dewatering 12 Other (Specify below)
 2 Irrigation 4 Industrial 7 Lawn and garden only 10 Monitoring well
 Was a chemical/bacteriological sample submitted to Department? Yes No If yes, mo/day/yr sample was submitted
 Water Well Disinfected? Yes No

5 TYPE OF BLANK CASING USED:
 1 Steel 3 RMP (SR) 5 Wrought iron 8 Concrete tile CASING JOINTS: Glued Clamped
 XX 2 PVC 4 ABS 6 Asbestos-Cement 9 Other (specify below) Welded
 Blank casing diameter 5" in. to 130' ft., Dia. in. to ft., Dia. in. to ft.
 Casing height above land surface 15" in., weight 2.87 lbs./ft. Wall thickness or gauge No. SDR 21
 TYPE OF SCREEN OR PERFORATION MATERIAL:
 1 Steel 3 Stainless steel 5 Fiberglass 8 RMP (SR) 10 Asbestos-cement
 2 Brass 4 Galvanized steel 6 Concrete tile 9 ABS 12 None used (open hole)
 SCREEN OR PERFORATION OPENINGS ARE:
 1 Continuous slot XX3 Mill slot 5 Gauzed wrapped 8 Saw cut 11 None (open hole)
 2 Louvered shutter 4 Key punched 6 Wire wrapped 9 Drilled holes
 7 Torch cut 10 Other (specify)
 SCREEN-PERFORATED INTERVALS: From 130' ft. to 140' ft., From ft. to ft.
 From ft. to ft., From ft. to ft.
 GRAVEL PACK INTERVALS: From ft. to ft., From ft. to ft.
 From 140' ft. to 33' ft., From ft. to ft.

6 GROUT MATERIAL: 1 Neat cement 2 Cement grout XX Bentonite 4 Other
 Grout Intervals: From 33' ft. to 4' ft., From ft. to ft., From ft. to ft.
 What is the nearest source of possible contamination:
 1 Septic tank 4 Lateral lines 7 Pit privy 10 Livestock pens 14 Abandoned water well
 2 Sewer lines 5 Cess pool 8 Sewage lagoon 11 Fuel storage 15 Oil well/Gas well
 3 Watertight sewer lines 6 Seepage pit X 9 Feedyard 12 Fertilizer storage 16 Other (specify below)
 13 Insecticide storage
 How many feet? APP 250'

Direction from well? <u>South west</u>		LITHOLOGIC LOG		FROM TO		TO	
FROM	TO			FROM	TO	TO	
0'	4'	Top soil.		93'	96'	Lime.	
4'	14'	Fine sand.		96'	104'	Clay.	
14'	26'	Medium fine sand.		104'	108'	Sandy clay.	
26'	34'	Clay.		108'	122'	Clay.	
34'	36'	Fine sand.		122'	127'	Medium Fine sand.	
36'	40'	Clay.		127'	128'	Course sand.	
40'	46'	Medium fine sand.		138'	140'	Red bed.	
46'	51'	Clay.					
51'	62'	Sandy clay.					
62'	66'	clay.					
66'	70'	Medium course sand.					
70'	74'	Limey clay.					
74'	79'	Course sand.					
79'	89'	Clay.					
89'	93'	Medium Fine sand.					

7 CONTRACTOR'S OR LANDOWNER'S CERTIFICATION: This water well was (1) constructed, (2) reconstructed, or (3) plugged under my jurisdiction and was completed on (mo/day/year) June 21 1996 and this record is true to the best of my knowledge and belief. Kansas Water Well Contractor's License No. 112 This Water Well Record was completed on (mo/day/yr) July 20 1996 under the business name of Wells Drilling Co. by (signature) Dal Wells