


1 LOCATION OF WATER WELL:	Fraction	Section Number	Township Number	Range Number
County: Kingman	NE 1/4 NW 1/4 NE 1/4	3	T 28 S	R 8 E/W

Distance and direction from nearest town or city street address of well if located within city?

3 miles West of Kingman, Kansas.

2 WATER WELL OWNER: P. J. McKenna	Board of Agriculture, Division of Water Resources
RR#, St. Address, Box #: Route 1	Application Number:
City, State, ZIP Code: Kingman, KS. 67068	

3 LOCATE WELL'S LOCATION WITH AN "X" IN SECTION BOX #1	4 DEPTH OF COMPLETED WELL: 61 ft. ELEVATION:
--	--

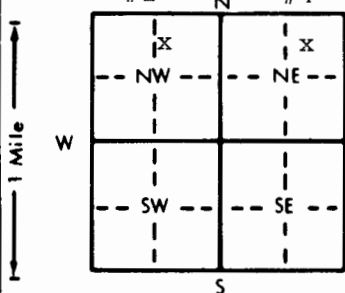

Depth(s) Groundwater Encountered 1. . . . . ft. 2. . . . . ft. 3. . . . . ft.
WELL'S STATIC WATER LEVEL 31 . . . . . ft. below land surface measured on mo/day/yr
Pump test data: Well water was . . . . . ft. after . . . . . hours pumping . . . . . gpm
Est. Yield . . . . . gpm: Well water was . . . . . ft. after . . . . . hours pumping . . . . . gpm
Bore Hole Diameter . . . . . in. to . . . . . ft., and . . . . . in. to . . . . . ft.
WELL WATER TO BE USED AS:
1 Domestic 3 Feedlot 6 Oil field water supply 8 Air conditioning 11 Injection well
2 Irrigation 4 Industrial 7 Lawn and garden only 9 Dewatering 12 Other (Specify below)
Was a chemical/bacteriological sample submitted to Department? Yes . . . . . No <u>X</u> . . . . . If yes, mo/day/yr sample was submitted
Water Well Disinfected? Yes . . . . . No

5 TYPE OF BLANK CASING USED:	5 Wrought iron	8 Concrete tile	CASING JOINTS: Glued . . . . . Clamped . . . . .
1 Steel	6 Asbestos-Cement	9 Other (specify below)	Welded . . . . .
2 PVC	7 Fiberglass		Threaded . . . . .
Blank casing diameter 5 . . . . . in. to . . . . . ft., Dia . . . . . in. to . . . . . ft., Dia . . . . . in. to . . . . . ft.			
Casing height above land surface 36 . . . . . in., weight . . . . . lbs./ft. Wall thickness or gauge No. . . . .			
TYPE OF SCREEN OR PERFORATION MATERIAL:	7 PVC	10 Asbestos-cement	
1 Steel	8 RMP (SR)	11 Other (specify) NA . . . . .	
2 Brass	9 ABS	12 None used (open hole)	
3 Stainless steel			
4 Galvanized steel			
5 Fiberglass			
6 Concrete tile			
SCREEN OR PERFORATION OPENINGS ARE:	5 Gauzed wrapped	8 Saw cut	11 None (open hole)
1 Continuous slot	6 Wire wrapped	9 Drilled holes	
2 Louvered shutter	7 Torch cut	10 Other (specify) NA . . . . .	
3 Mill slot			
4 Key punched			
SCREEN-PERFORATED INTERVALS: From NA . . . . . ft. to NA . . . . . ft., From . . . . . ft. to . . . . . ft., From . . . . . ft. to . . . . . ft.			
GRAVEL PACK INTERVALS: From . . . . . ft. to . . . . . ft., From . . . . . ft. to . . . . . ft., From . . . . . ft. to . . . . . ft.			

6 GROUT MATERIAL:	1 Neat cement	2 Cement grout	3 Bentonite	4 Other . . . . .
Grout Intervals: From 9 . . . . . ft. to 3 . . . . . ft., From . . . . . ft. to . . . . . ft., From . . . . . ft. to . . . . . ft.				
What is the nearest source of possible contamination: See Below	10 Livestock pens	14 Abandoned water well		
1 Septic tank	11 Fuel storage	15 Oil well/Gas well		
2 Sewer lines	12 Fertilizer storage	16 Other (specify below)		
3 Watertight sewer lines	13 Insecticide storage	Open pasture . . . . .		
4 Lateral lines				
5 Cess pool				
6 Seepage pit				
7 Pit privy				
8 Sewage lagoon				
9 Feedyard				

Direction from well?	How many feet?
FROM TO LITHOLOGIC LOG	FROM TO PLUGGING INTERVALS
Plugged Well #1	This well was left by a drilling company approximately 17 years ago.
This abandoned oil test water supply well was plugged according to instructions from water quality handbook MF 935.	
After the chlorination process the well was filled with washed sand to static water level 31 feet, then 21 feet of Bentonite, then 6 feet of cement with a cement cap, then 3 feet of packed soil.	
Total depth to rock, 61 feet.	

7 CONTRACTOR'S OR LANDOWNER'S CERTIFICATION: This water well was (1) constructed, (2) reconstructed, or (3) plugged under my jurisdiction and was completed on (mo/day/year) July 15, 1992 . . . . . and this record is true to the best of my knowledge and belief. Kansas Water Well Contractor's License No. . . . . This Water Well Record was completed on (mo/day/yr) July 16, 1992 . . . . . under the business name of McKenna Ranch . . . . . by (signature) P. J. McKenna
---