


1 LOCATION OF WATER WELL: Fraction  $\frac{1}{4}$  SW  $\frac{1}{4}$  SW  $\frac{1}{4}$  Section Number 6 Township Number T 28 S Range Number R 8 **E/W**  
 County: Kingman

Distance and direction from nearest town or city street address of well if located within city?  
 7 West & 1 East of Kingman on Highway 54

2 WATER WELL OWNER: Western Resources - KPL  
 RR#, St. Address, Box #: P.O. Box 494 Board of Agriculture, Division of Water Resources  
 City, State, ZIP Code: Kingman, Ks. 67068 Application Number:

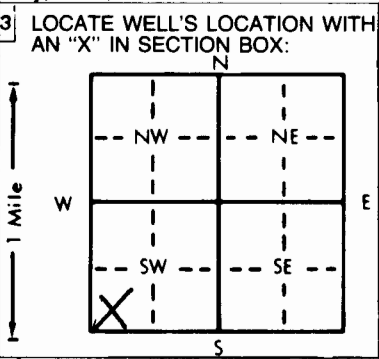

4 DEPTH OF COMPLETED WELL: 39 ft. ELEVATION:  
 Depth(s) Groundwater Encountered 1. . . . . ft. 2. . . . . ft. 3. . . . . ft.  
 WELL'S STATIC WATER LEVEL: 25.5 ft. below land surface measured on mo/day/yr 09-18-92  
 Pump test data: Well water was . . . . . ft. after . . . . . hours pumping . . . . . gpm  
 Est. Yield . . . . . gpm: Well water was . . . . . ft. after . . . . . hours pumping . . . . . gpm  
 Bore Hole Diameter: 4.75 in. to 81 . . . . . ft., and 8 . . . . . in. to 45 . . . . . ft.  
 WELL WATER TO BE USED AS: 5 Public water supply 8 Air conditioning 11 Injection well  
 1 Domestic 3 Feedlot 6 Oil field water supply 9 Dewatering 12 Other (Specify below)  
 2 Irrigation 4 Industrial 7 Lawn and garden only **10** Monitoring well  
 Was a chemical/bacteriological sample submitted to Department? Yes  No ; If yes, mo/day/yr sample was submitted  
 Water Well Disinfected? Yes  No

5 TYPE OF BLANK CASING USED: 5 Wrought iron 8 Concrete tile CASING JOINTS: Glued . . . . . Clamped . . . . .  
 1 Steel 3 RMP (SR) 6 Asbestos-Cement 9 Other (specify below) Welded . . . . .  
**2** PVC 4 ABS 7 Fiberglass Threaded   
 Blank casing diameter . . . . . 2 . . . . . in. to 24 . . . . . ft., Dia . . . . . in. to . . . . . ft., Dia . . . . . in. to . . . . . ft.  
 Casing height above land surface . . . . . 24 . . . . . in., weight . . . . . lbs./ft. Wall thickness or gauge No. Sch. 40  
 TYPE OF SCREEN OR PERFORATION MATERIAL: 7 PVC 10 Asbestos-cement  
 1 Steel **3** Stainless steel .010 5 Fiberglass 8 RMP (SR) 11 Other (specify) . . . . .  
 2 Brass 4 Galvanized steel 6 Concrete tile 9 ABS 12 None used (open hole)  
 SCREEN OR PERFORATION OPENINGS ARE: 5 Gauzed wrapped 8 Saw cut 11 None (open hole)  
 1 Continuous slot 3 Mill slot **6** Wire wrapped 9 Drilled holes  
 2 Louvered shutter 4 Key punched 7 Torch cut 10 Other (specify) . . . . .  
 SCREEN-PERFORATED INTERVALS: From . . . . . 39 . . . . . ft. to . . . . . 24 . . . . . ft., From . . . . . ft. to . . . . . ft.  
 GRAVEL PACK INTERVALS: From . . . . . 40 . . . . . ft. to . . . . . 22 . . . . . ft., From . . . . . ft. to . . . . . ft.  
 From . . . . . ft. to . . . . . ft., From . . . . . ft. to . . . . . ft.

6 GROUT MATERIAL: 1 Neat cement **2** Cement grout **3** Bentonite 4 Other . . . . .  
 Grout Intervals: From . . . . . 45 . . . . . ft. to 40 (bent) . . . . . ft., From . . . . . 22 . . . . . ft. to 20 (bent) . . . . . ft., From . . . . . 20 . . . . . ft. to 0 (cement) . . . . . ft.  
 What is the nearest source of possible contamination: 10 Livestock pens 14 Abandoned water well  
 1 Septic tank 4 Lateral lines 7 Pit privy 11 Fuel storage 15 Oil well/Gas well  
 2 Sewer lines 5 Cess pool 8 Sewage lagoon 12 Fertilizer storage **16** Other (specify below)  
 3 Watertight sewer lines 6 Seepage pit 9 Feedyard 13 Insecticide storage **Industrial Lagoon**  
 Direction from well? south How many feet? 250

FROM	TO	LITHOLOGIC LOG	FROM	TO	PLUGGING INTERVALS
0	2	Sand-silty, fine to medium, yellow brown			
2	17.5	Sand-fine to medium, yellow brown			
17.5	19	Clay-sandy, yellow brown			RW-3S
19	25	Sand-fine to coarse, yellow brown			
25	35	Sand-gravelly, fine to coarse			
35	37	Sand-clayey, fine to medium, yellow brown			
37	37.5	Sand-medium, yellow brown			
37.5	41	Clay-sandy brown			
41	48	Sand-fine to medium, yellow brown			
48	56	Sand-fine, trace silt, yellow brown			
56	65	Sand-fine to medium, yellow brown, trace gravel			
65	70.5	Sand-fine to coarse, yellow brown, trace gravel, gray & brown clay seams			
70.5	72	Clay-sandy reddish brown, trace sand			
72	80	Sand-fine to medium, yellow brown, trace gravel			
80	81	Shale, weathered, reddish brown			

7 CONTRACTOR'S OR LANDOWNER'S CERTIFICATION: This water well was **1** constructed, (2) reconstructed, or (3) plugged under my jurisdiction and was completed on (mo/day/year) 09-16-92 and this record is true to the best of my knowledge and belief. Kansas Water Well Contractor's License No. 527 This Water Well Record was completed on (mo/day/yr) 01-07-93 under the business name of GeoCore Services, Inc. by (signature) *Dak a Roll*

INSTRUCTIONS: Use typewriter or ball point pen. PLEASE PRESS FIRMLY and PRINT clearly. Please fill in blanks, underline or circle the correct answers. Send top three copies to Kansas Department of Health and Environment, Bureau of Water, Topeka, Kansas 66620-0001. Telephone: 913-296-5545. Send one to WATER WELL OWNER and retain one for your records.