


74-3-93

WATER WELL RECORD Form WWC-5 KSA 82a-1212

|                           |                             |                |                 |              |
|---------------------------|-----------------------------|----------------|-----------------|--------------|
| 1 LOCATION OF WATER WELL: | Fraction                    | Section Number | Township Number | Range Number |
| County: <u>Kingman</u>    | <u>SE 1/4 SW 1/4 SW 1/4</u> | <u>9</u>       | <u>T 28 S</u>   | <u>R 8 W</u> |

Distance and direction from nearest town or city street address of well if located within city?  
5 Miles West, 1 1/4 Miles South Of Kingman, Kans.

2 WATER WELL OWNER: City Of Kingman  
 RR#, St. Address, Box # : Kingman, Kansas  
 City, State, ZIP Code : \_\_\_\_\_  
 Board of Agriculture, Division of Water Resources  
 Application Number: \_\_\_\_\_

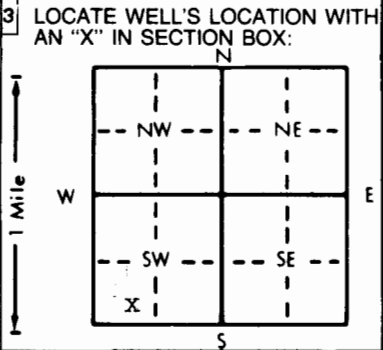

4 DEPTH OF COMPLETED WELL: 71' ft. ELEVATION: 1506  
 Depth(s) Groundwater Encountered 1. 20' ft. 2. \_\_\_\_\_ ft. 3. \_\_\_\_\_ ft.  
 WELL'S STATIC WATER LEVEL 17.3" ft. below land surface measured on mo/day/yr Mar 31-93  
 Pump test data: Well water was 21.4" ft. after 4 hours pumping \_\_\_\_\_ gpm  
 Est. Yield 35 gpm: Well water was 21.4 ft. after 4 hours pumping \_\_\_\_\_ gpm  
 Bore Hole Diameter: 6 3/4 in. to 71' ft., and \_\_\_\_\_ in. to \_\_\_\_\_ ft.  
 WELL WATER TO BE USED AS:  
 5 Public water supply 8 Air conditioning 11 Injection well  
 1 Domestic 3 Feedlot 6 Oil field water supply 9 Dewatering XX12 Other (Specify below)  
 2 Irrigation 4 Industrial 7 Lawn and garden only 10 Monitoring Well Test Well  
 Was a chemical/bacteriological sample submitted to Department? Yes \_\_\_\_\_ No X; If yes, mo/day/yr sample was submitted \_\_\_\_\_  
 Water Well Disinfected? Yes X No \_\_\_\_\_

5 TYPE OF BLANK CASING USED:  
 1 Steel 3 RMP (SR) 5 Wrought iron 8 Concrete tile CASING JOINTS: Glued X Clamped \_\_\_\_\_  
XX PVC 4 ABS 6 Asbestos-Cement 9 Other (specify below) Welded \_\_\_\_\_  
 7 Fiberglass \_\_\_\_\_ Threaded \_\_\_\_\_  
 Blank casing diameter \_\_\_\_\_ in. to \_\_\_\_\_ ft., Dia \_\_\_\_\_ in. to \_\_\_\_\_ ft., Dia \_\_\_\_\_ in. to \_\_\_\_\_ ft.  
 Casing height above land surface 24" in., weight 160 lbs./ft. Wall thickness or gauge No. 160  
 TYPE OF SCREEN OR PERFORATION MATERIAL: XX7 PVC 10 Asbestos-cement  
 1 Steel 3 Stainless steel 5 Fiberglass 8 RMP (SR) 11 Other (specify) \_\_\_\_\_  
 2 Brass 4 Galvanized steel 6 Concrete tile 9 ABS 12 None used (open hole)  
 SCREEN OR PERFORATION OPENINGS ARE:  
 5 Gauzed wrapped XX8 Saw cut 11 None (open hole)  
 1 Continuous slot 3 Mill slot 6 Wire wrapped 9 Drilled holes  
 2 Louvered shutter 4 Key punched 7 Torch cut 10 Other (specify) \_\_\_\_\_  
 SCREEN-PERFORATED INTERVALS: From 56' ft. to 69' ft., From \_\_\_\_\_ ft. to \_\_\_\_\_ ft.  
 From \_\_\_\_\_ ft. to \_\_\_\_\_ ft., From \_\_\_\_\_ ft. to \_\_\_\_\_ ft.  
 GRAVEL PACK INTERVALS: From 51 ft. to 71 ft., From 43 ft. to 21 ft.  
 From \_\_\_\_\_ ft. to \_\_\_\_\_ ft., From \_\_\_\_\_ ft. to \_\_\_\_\_ ft.

6 GROUT MATERIAL: 1 Neat cement 2 Cement grout XX9 Bentonite 4 Other \_\_\_\_\_  
 Grout Intervals: From 21 ft. to 2 ft., From \_\_\_\_\_ ft. to \_\_\_\_\_ ft., From \_\_\_\_\_ ft. to \_\_\_\_\_ ft.  
 What is the nearest source of possible contamination:  
 1 Septic tank 4 Lateral lines 7 Pit privy XXX0 Livestock pens 14 Abandoned water well  
 2 Sewer lines 5 Cess pool 8 Sewage lagoon 11 Fuel storage 15 Oil well/Gas well  
 3 Watertight sewer lines 6 Seepage pit 9 Feedyard 12 Fertilizer storage 16 Other (specify below)  
 13 Insecticide storage \_\_\_\_\_  
 Direction from well? South East How many feet? App. 2640'

| FROM | TO  | LITHOLOGIC LOG                     | FROM | TO | PLUGGING INTERVALS |
|------|-----|------------------------------------|------|----|--------------------|
| 0'   | 5'  | Brown Sandy Top Soil.              |      |    |                    |
| 5'   | 11' | Medium Course Sand.                |      |    |                    |
| 11'  | 12' | Clay.                              |      |    |                    |
| 12'  | 37' | Medium to Fine Sand .              |      |    |                    |
| 37'  | 53' | Fine Sand & Gravel W/ Clay Strips. |      |    |                    |
| 53'  | 70' | Course Sand & Gravel.              |      |    |                    |
| 70'  | 71' | Red Bed.                           |      |    |                    |

*Test for City Water Supply.*

7 CONTRACTOR'S OR LANDOWNER'S CERTIFICATION: This water well was (1) constructed, (2) reconstructed, or (3) plugged under my jurisdiction and was completed on (mo/day/year) Mar. 22-93 and this record is true to the best of my knowledge and belief. Kansas Water Well Contractor's License No. 112 This Water Well Record was completed on (mo/day/yr) April 1 -93 under the business name of Wells Drilling Co. by (signature) Dal Wells

INSTRUCTIONS: Use typewriter or ball point pen. PLEASE PRESS FIRMLY and PRINT clearly. Please fill in blanks, underline or circle the correct answers. Send top three copies to Kansas Department of Health and Environment, Bureau of Water, Topeka, Kansas 66620-0001. Telephone: 913-296-5545. Send one to WATER WELL OWNER and retain one for your records.