


1 LOCATION OF WATER WELL: Fraction NW 1/4 NW 1/4 NW 1/4 Section Number 9 Township Number T 28 S Range Number R 8 ~~W~~

Distance and direction from nearest town or city street address of well if located within city?
 5 Miles WEST 1 1/4 Miles South Of Kingman, Kns.

2 WATER WELL OWNER: City Of Kingman
 RR#, St. Address, Box #: Kingman, Kansas 67068
 City, State, ZIP Code: Board of Agriculture, Division of Water Resources
 Application Number:

3 LOCATE WELL'S LOCATION WITH AN "X" IN SECTION BOX:

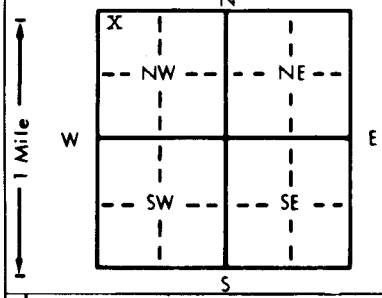

4 DEPTH OF COMPLETED WELL: 58' ft. ELEVATION: 1507

Depth(s) Groundwater Encountered 1. ft. 2. ft. 3. ft.
 WELL'S STATIC WATER LEVEL: 7' ft. below land surface measured on mo/day/yr Mar, 31-93
 Pump test data: Well water was ft. after hours pumping gpm
 Est. Yield: 30 gpm; Well water was ft. after hours pumping gpm
 Bore Hole Diameter: 6 3/4" in. to 58' ft., and in. to ft.
 WELL WATER TO BE USED AS:
 X 5 Public water supply 8 Air conditioning 11 Injection well
 1 Domestic 3 Feedlot 6 Oil field water supply 9 Dewatering
 2 Irrigation 4 Industrial 7 Lawn and garden only 10 Monitoring well ~~XXXXXX~~ 12 Other (Specify below) Test well
 Was a chemical/bacteriological sample submitted to Department? Yes No X; If yes, mo/day/yr sample was submitted
 Water Well Disinfected? Yes X No

5 TYPE OF BLANK CASING USED:
 1 Steel 3 RMP (SR) 5 Wrought iron 8 Concrete tile CASING JOINTS: Glued X Clamped
 XX 2 PVC 4 ABS 6 Asbestos-Cement 9 Other (specify below) Welded
 7 Fiberglass Threaded

Blank casing diameter: 3" in. to 52' ft., Dia. in. to ft., Dia. in. to ft.
 Casing height above land surface: 24" in., weight 160 lbs./ft. Wall thickness or gauge No. 160

TYPE OF SCREEN OR PERFORATION MATERIAL:
 1 Steel 3 Stainless steel 5 Fiberglass 8 RMP (SR) 10 Asbestos-cement
 2 Brass 4 Galvanized steel 6 Concrete tile 9 ABS 11 Other (specify)
 12 None used (open hole)

SCREEN OR PERFORATION OPENINGS ARE:
 1 Continuous slot 3 Mill slot 5 Gauzed wrapped X 8 Saw cut 11 None (open hole)
 2 Louvered shutter 4 Key punched 6 Wire wrapped 9 Drilled holes
 7 Torch cut 10 Other (specify)

SCREEN-PERFORATED INTERVALS: From 58' ft. to 52' ft., From ft. to ft.
 From ft. to ft., From ft. to ft.
 GRAVEL PACK INTERVALS: From 58' ft. to 50' ft., From ft. to ft.
 From 46' ft. to 19' ft., From ft. to ft.

6 GROUT MATERIAL: 1 Neat cement 2 Cement grout X 3 Bentonite 4 Other
 Grout Intervals: From 46' ft. to 50' ft., From 19' ft. to 2.5' ft., From ft. to ft.

What is the nearest source of possible contamination:
 1 Septic tank 4 Lateral lines 7 Pit privy X 10 Livestock pens 14 Abandoned water well
 2 Sewer lines 5 Cess pool 8 Sewage lagoon 11 Fuel storage 15 Oil well/Gas well
 3 Watertight sewer lines 6 Seepage pit 9 Feedyard 12 Fertilizer storage 16 Other (specify below)
 13 Insecticide storage

Direction from well? SE How many feet? App. 2640'

FROM	TO	LITHOLOGIC LOG	FROM	TO	PLUGGING INTERVALS
0'	11'	Sand & silt.			
11'	20'	Clay, Sand & Fine Gravel.			
20'	48'	Medium Sand & Gravel.			
48'	50'	Sandy Clay.			
50'	54'	Course Sand & Fine Gravel.			
54'	58'	Red Bed.			

7 CONTRACTOR'S OR LANDOWNER'S CERTIFICATION: This water well was (1) constructed, (2) reconstructed, or (3) plugged under my jurisdiction and was completed on (mo/day/year) Mar. 16-93 and this record is true to the best of my knowledge and belief. Kansas Water Well Contractor's License No. 112 This Water Well Record was completed on (mo/day/yr) Mar. 31-93 under the business name of Wells Drilling Co. by (signature) Dal Wells