WATER WELL RECORD Form WWC-5 KSA 82a-1212

1 LOCATION OF WATER WELL: County: KINGMAN | Fraction: C OF NW ¼ SW ¼ | Section Number: 13 | Township Number: T 28 S | Range Number: R 8 E (W)

Distance and direction from nearest town or city? 2W 3½ S OF KINGMAN, KS | Street address of well if located within city?

2 WATER WELL OWNER: H-30 Drilling Company
RR#, St. Address, Box # : 251 N. Water Suite 10
City, State, ZIP Code : Wichita, Kansas 67202
Board of Agriculture, Division of Water Resources Application Number:

3 DEPTH OF COMPLETED WELL 60 ft. Bore Hole Diameter 10 in. to ft., and in. to ft.

Well Water to be used as: 1 Domestic 3 Feedlot 6 Oil field water supply 8 Air conditioning 11 Injection well; 2 Irrigation 4 Industrial 7 Lawn and garden only 9 Dewatering 10 Observation well 12 Other (Specify below)

Well's static water level 23 ft. below land surface measured on Apr. month 1 day 81 year

Pump Test Data: Well water was ft. after hours pumping gpm
Est. Yield 60 gpm: Well water was ft. after hours pumping gpm

4 TYPE OF BLANK CASING USED: 1 Steel 3 RMP (SR) 5 Wrought iron 6 Asbestos-Cement 8 Concrete tile 9 Other (specify below); 2 PVC 4 ABS 7 Fiberglass

Casing Joints: Glued X Clamped Welded Threaded

Blank casing dia 5 in. to 40 ft., Dia in. to ft., Dia in. to ft.

Casing height above land surface 12 in., weight lbs./ft. Wall thickness or gauge No .214

TYPE OF SCREEN OR PERFORATION MATERIAL: 1 Steel 3 Stainless steel 5 Fiberglass 7 PVC 8 RMP (SR) 10 Asbestos-cement; 2 Brass 4 Galvanized steel 6 Concrete tile 9 ABS 11 Other (specify) 12 None used (open hole)

Screen or Perforation Openings Are: 1 Continuous slot 3 Mill slot 5 Gauzed wrapped 6 Wire wrapped 8 Saw cut 9 Drilled holes 11 None (open hole); 2 Louvered shutter 4 Key punched 7 Torch cut 10 Other (specify)

Screen-Perforation Dia 5 in. to ft., Dia in. to ft., Dia in. to ft.

Screen-Perforated Intervals: From 40 ft. to 60 ft., From ft. to ft.
From ft. to ft., From ft. to ft.

Gravel Pack Intervals: From ft. to ft., From ft. to ft.
From 10 ft. to 60 ft., From ft. to ft.

5 GROUT MATERIAL: 1 Neat cement 2 Cement grout 3 Bentonite 4 Other

Grouted Intervals: From 0 ft. to 10 ft., From ft. to ft., From ft. to ft.

What is the nearest source of possible contamination: 1 Septic tank 2 Sewer lines 3 Lateral lines 4 Cess pool 5 Seepage pit 6 Pit privy 7 Sewage lagoon 8 Feed yard 9 Livestock pens 10 Fuel storage 11 Fertilizer storage 12 Insecticide storage 13 Watertight sewer lines 14 Abandoned water well 15 Oil well/Gas well 16 Other (specify below) None

Direction from well How many feet ? Water Well Disinfected? Yes X No

Was a chemical/bacteriological sample submitted to Department? Yes No X If yes, date sample was submitted month day year: Pump Installed? Yes No X

If Yes: Pump Manufacturer's name Model No. HP Volts

Depth of Pump Intake ft. Pumps Capacity rated at gal./min.

Type of pump: 1 Submersible 2 Turbine 3 Jet 4 Centrifugal 5 Reciprocating 6 Other

6 CONTRACTOR'S OR LANDOWNER'S CERTIFICATION: This water well was (1) constructed, (2) reconstructed, or (3) plugged under my jurisdiction and was completed on APRIL month 1 day 81 year, and this record is true to the best of my knowledge and belief. Kansas Water Well Contractor's License No. 325

This Water Well Record was completed on June month 9 day 81 year under the business name of Central Well & Pump Inc. Pratt, Kansas by (signature) [signature]

7 LOCATE WELL'S LOCATION WITH AN "X" IN SECTION BOX:

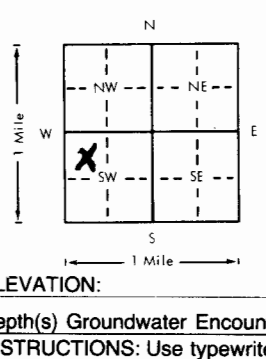

ELEVATION:

FROM	TO	LITHOLOGIC LOG	FROM	TO	LITHOLOGIC LOG
0	2	Top soil			
2	5	Clay, brown			
5	30	Sand, fine to med			
30	50	Sand, fine to coarse with a little fine gravel, loose			
50	58	Sand, fine to med			
58	80	Clay, blue			
80	85	Sand, very fine to fine, silty			
85	90	Shale, red			

Depth(s) Groundwater Encountered 1. 23 ft. 2. ft. 3. ft. 4. ft. (Use a second sheet if needed)

INSTRUCTIONS: Use typewriter or ball point pen, *please press firmly* and *PRINT* clearly. Please fill in blanks, underline or circle the correct answers. Send top three copies to Kansas Department of Health and Environment, Division of Environment, Water Well Contractors, Topeka, KS 66620. Send one to WATER WELL OWNER and retain one for your records.

OFFICE USE ONLY