

USE TYPEWRITER OR BALL POINT PEN-PRESS FIRMLY, PRINT CLEARLY.


WATER WELL RECORD
KSA 82a-1201-1215

Kansas Department of Health and Environment-Division of Environment
(Water well Contractors)
Topeka, Kansas 66620

Van Tugel #1

1. Location of well: County Kingman Fraction C-NE-4 Section number 14 Township number 28 S Range number 8 W

2. Distance and direction from nearest town or city: 3 south
Street address of well location if in city: 4 1/2 West Kingman
3. Owner of well: Search Drilling Co
R.R. or street: Whitaker Kansas
City, state, zip code:

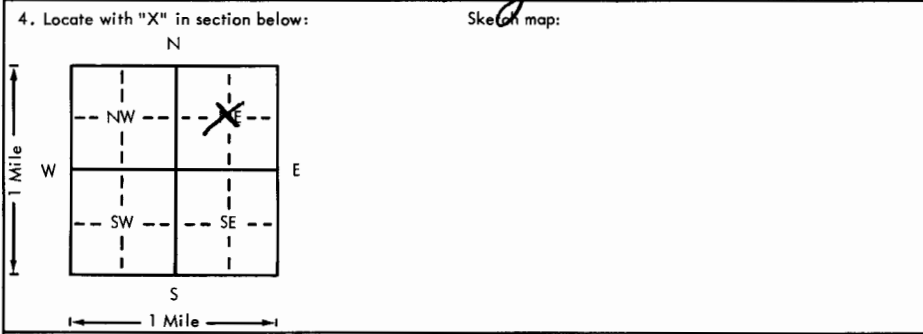

6. Bore hole dia. 8 in. Completion date 3-21-77
Well depth 55 ft.
7. Cable tool Rotary Driven Dug
 Hollow rod Jetted Bored Reverse rotary
8. Use: Domestic Public supply Industry
 Irrigation Air conditioning Stock
 Lawn Oil field water Other
9. Casing: Material Plastic Height: Above or below
Threaded Welded Surface 12 in.
RMP PVC Weight 287.3 lbs./ft.
Dia. 5 in. to 55 ft. depth; Wall thickness: inches or
Dia. in. to ft. depth; gage No. 200

5. Type and color of material

	From	To
<u>Clay</u>	<u>0</u>	<u>10</u>
<u>Sand</u>	<u>10</u>	<u>35</u>
<u>Gravel</u>	<u>35</u>	<u>55</u>

10. Screen: Manufacturer's name Self made
Type PVC Dia. 5
Slot/gauze 5 Length 20
Set between 35 ft. and 55 ft.
Gravel pack? yes Size range of material 1/8 - 1/4
11. Static water level: 25 ft. below land surface Date 3-21-77
12. Pumping level below land surfaces:
 ft. after hrs. pumping g.p.m.
 ft. after hrs. pumping g.p.m.
Estimated maximum yield g.p.m.
13. Water sample submitted: mo./day/yr.
 Yes No Date
14. Well head completion:
 Pitless adapter inches above grade
15. Well grouted? yes
With: Neat cement Bentonite Concrete
Depth: From 0 ft. to 10 ft.
16. Nearest source of possible contamination:
ft. Direction Type
Well disinfected upon completion? Yes No
17. Pump: Not installed
Manufacturer's name
Model number HP Volts
Length of drop pipe ft. capacity g.p.m.
Type:
 Submersible Turbine
 Jet Reciprocating
 Centrifugal Other

18. Elevation:
Topography:
 Hill
 Slope
 Upland
 Valley
19. Remarks:

20. Water well contractor's certification:
This well was drilled under my jurisdiction and this report is true to the best of my knowledge and belief.
Myers Water Well
Business name License No.
Address 1st Bend Ks 143
Signed A Myers Date 3-21-77
Authorized representative

28-8-14 CNE 1/4 1/4 1/4