


1 LOCATION OF WATER WELL: County: Kingman Fraction: SE 1/4 NE 1/4 SW 1/4 Section Number: 14 Township Number: T 28s S Range Number: R 8

Distance and direction from nearest town or city street address of well if located within city?  
1Mi. so.-2 1/2 West of Kingman, Kns.

2 WATER WELL OWNER: Linn Wilson  
 RR#, St. Address, Box #: RT#2 Board of Agriculture, Division of Water Resources  
 City, State, ZIP Code: Kingman, Kns. Application Number:

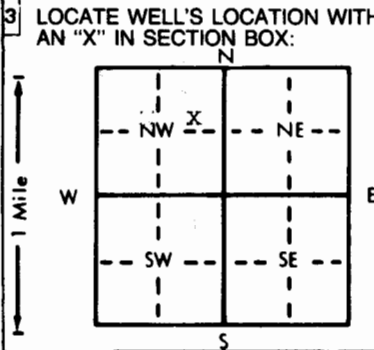

4 DEPTH OF COMPLETED WELL: 31 ft. ELEVATION: ..... ft.  
 Depth(s) Groundwater Encountered 1. 3' ..... ft. 2. .... ft. 3. .... ft.  
 WELL'S STATIC WATER LEVEL 8' ..... ft. below land surface measured on mo/day/yr .....  
 Pump test data: Well water was ~~7'~~ 9' ..... ft. after 2 ..... hours pumping ..... gpm  
 Est. Yield 30 ..... gpm: Well water was ..... ft. after ..... hours pumping ..... gpm  
 Bore Hole Diameter 7 7/8 in. to 31 ..... ft., and ..... in. to ..... ft.  
 WELL WATER TO BE USED AS: 5 Public water supply 8 Air conditioning 11 Injection well  
 XX Domestic 3 Feedlot 6 Oil field water supply 9 Dewatering 12 Other (Specify below)  
 2 Irrigation 4 Industrial 7 Lawn and garden only 10 Monitoring well .....  
 Was a chemical/bacteriological sample submitted to Department? Yes ..... No X .....; If yes, mo/day/yr sample was submitted  
 Water Well Disinfected? Yes X No

5 TYPE OF BLANK CASING USED: 1 Steel 3 RMP (SR) 5 Wrought iron 8 Concrete tile CASING JOINTS: Glued X Clamped .....  
 2 ~~PVC~~ 4 ABS 6 Asbestos-Cement 9 Other (specify below) Welded .....  
 7 Fiberglass Threaded .....  
 Blank casing diameter 5 ..... in. to ..... ft., Dia ..... in. to ..... ft., Dia ..... in. to ..... ft.  
 Casing height above land surface 12 ..... in., weight ..... lbs./ft. Wall thickness or gauge No. ....  
 TYPE OF SCREEN OR PERFORATION MATERIAL: 7 ~~PVC~~ 10 Asbestos-cement  
 1 Steel 3 Stainless steel 5 Fiberglass 8 RMP (SR) 11 Other (specify) .....  
 2 Brass 4 Galvanized steel 6 Concrete tile 9 ABS 12 None used (open hole)  
 SCREEN OR PERFORATION OPENINGS ARE: 5 Gauzed wrapped 8 Saw cut 11 None (open hole)  
 1 Continuous slot 3 Mill slot 6 Wire wrapped 9 Drilled holes  
 2 Louvered shutter 4 Key punched 7 Torch cut 10 Other (specify) .....  
 SCREEN-PERFORATED INTERVALS: From 31' ..... ft. to 22' ..... ft., From ..... ft. to ..... ft.  
 From ..... ft. to ..... ft., From ..... ft. to ..... ft.  
 GRAVEL PACK INTERVALS: From 31' ..... ft. to 20' ..... ft., From ..... ft. to ..... ft.  
 From ..... ft. to ..... ft., From ..... ft. to ..... ft.

6 GROUT MATERIAL: 1 Neat cement 2 Cement grout XX 3 Bentonite 4 Other .....  
 Grout Intervals: From 20' ..... ft. to 2' ..... ft., From ..... ft. to ..... ft., From ..... ft. to ..... ft.  
 What is the nearest source of possible contamination: 10 Livestock pens 14 Abandoned water well  
 XX 1 Septic tank 4 Lateral lines 7 Pit privy 11 Fuel storage 15 Oil well/Gas well  
 2 Sewer lines 5 Cess pool 8 Sewage lagoon 12 Fertilizer storage 16 Other (specify below)  
 3 Watertight sewer lines 6 Seepage pit 9 Feedyard 13 Insecticide storage  
 Direction from well? North How many feet? 1320'

FROM	TO	LITHOLOGIC LOG	FROM	TO	PLUGGING INTERVALS
0'	4'	Top soil .			
4'	8'	Sandy clay,			
8'	20'	Fine sand,			
20'	30'	Course sand & fine Gravel,			
30'	31'	Red bed,			

7 CONTRACTOR'S OR LANDOWNER'S CERTIFICATION: This water well was (1) constructed, (2) reconstructed, or (3) plugged under my jurisdiction and was completed on (mo/day/year) Nov. 1 - 91 ..... and this record is true to the best of my knowledge and belief. Kansas Water Well Contractor's License No. 112 ..... This Water Well Record was completed on (mo/day/yr) Nov. 5 - 91 ..... under the business name of Wells Drilling Co. by (signature) Wal Wells

INSTRUCTIONS: Use typewriter or ball point pen. PLEASE PRESS FIRMLY and PRINT clearly. Please fill in blanks, underline or circle the correct answers. Send top three copies to Kansas Department of Health and Environment, Bureau of Water, Topeka, Kansas 66620-0001. Telephone: 913-296-5545. Send one to WATER WELL OWNER and retain one for your records.

27128190168