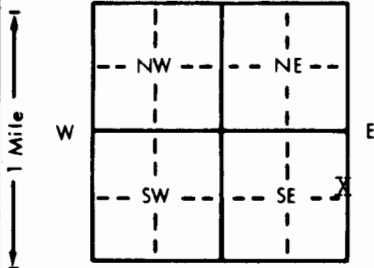


1 LOCATION OF WATER WELL: County: <u>Kingman</u>		Fraction <u>SE</u> 1/4 <u>NE</u> 1/4 <u>SE</u> 1/4	Section Number <u>25</u>	Township Number T <u>28</u> S	Range Number R <u>8W</u> E/W
Distance and direction from nearest town or city street address of well if located within city? <u>1/2 S, 1 W of Kingman, Kansas</u>					
2 WATER WELL OWNER: <u>Bernard Gillen</u>		<u>White & Ellis Drilling</u>		<u>Gillen No. 1</u>	
RR#, St. Address, Box #: <u>Route 1</u>		<u>491 E Douglas</u>		Board of Agriculture, Division of Water Resources	
City, State, ZIP Code: <u>Zenda, Ks. 67159</u>		<u>Wichita, Ks. 67202</u>		Application Number: <u>Unknown</u>	
3 LOCATE WELL'S LOCATION WITH AN "X" IN SECTION BOX: 		4 DEPTH OF COMPLETED WELL: <u>130</u> ft. ELEVATION: <u>Unknown</u> Depth(s) Groundwater Encountered 1. <u>28</u> ft. 2. _____ ft. 3. _____ ft. WELL'S STATIC WATER LEVEL: <u>28</u> ft. below land surface measured on mo/day/yr <u>1/5/84</u> Pump test data: Well water was _____ ft. after _____ hours pumping _____ gpm Est. Yield <u>60</u> gpm: Well water was _____ ft. after _____ hours pumping _____ gpm Bore Hole Diameter: <u>8</u> in. to <u>130</u> ft., and _____ in. to _____ ft. WELL WATER TO BE USED AS: 1 Domestic 3 Feedlot <u>6 Oil field water supply</u> 9 Dewatering 12 Other (Specify below) 2 Irrigation 4 Industrial 7 Lawn and garden only 10 Observation well Was a chemical/bacteriological sample submitted to Department? Yes _____ No _____; If yes, mo/day/yr sample was submitted _____ Water Well Disinfected? Yes _____ No _____			
5 TYPE OF BLANK CASING USED: 1 Steel 3 RMP (SR) 5 Wrought iron 8 Concrete tile 2 <u>PVC</u> 4 ABS 6 Asbestos-Cement 9 Other (specify below) Blank casing diameter <u>5</u> in. to <u>110</u> ft., Dia _____ in. to _____ ft., Dia _____ in. to _____ ft. Casing height above land surface: <u>12</u> in., weight <u>2.8</u> lbs./ft. Wall thickness or gauge No. <u>Sch. 40</u>		CASING JOINTS: <u>Glued</u> _____ Clamped _____ Welded _____ Threaded _____			
TYPE OF SCREEN OR PERFORATION MATERIAL: 1 Steel 3 Stainless steel 5 Fiberglass 8 RMP (SR) 2 Brass 4 Galvanized steel 6 Concrete tile 9 ABS		7 <u>PVC</u> 10 Asbestos-cement 11 Other (specify) _____ 12 None used (open hole)			
SCREEN OR PERFORATION OPENINGS ARE: 1 Continuous slot 3 Mill slot 5 Gauzed wrapped 8 <u>Saw cut</u> 2 Louvered shutter 4 Key punched 6 Wire wrapped 9 Drilled holes 7 Torch cut 10 Other (specify) _____		11 None (open hole)			
SCREEN-PERFORATED INTERVALS: From _____ ft. to _____ ft., From _____ ft. to _____ ft. From _____ ft. to _____ ft., From _____ ft. to _____ ft.					
GRAVEL PACK INTERVALS: From _____ ft. to _____ ft., From _____ ft. to _____ ft. From _____ ft. to _____ ft., From _____ ft. to _____ ft.					
6 GROUT MATERIAL: 1 <u>Neat cement</u> 2 Cement grout 3 Bentonite 4 Other _____					
Grout Intervals: From _____ ft. to _____ ft., From _____ ft. to _____ ft.					
What is the nearest source of possible contamination: 1 Septic tank 4 Lateral lines 7 Pit privy 10 Livestock pens 14 Abandoned water well 2 Sewer lines 5 Cess pool 8 Sewage lagoon 11 Fuel storage 15 <u>Oil well/Gas well</u> 3 Watertight sewer lines 6 Seepage pit 9 Feedyard 12 Fertilizer storage 16 Other (specify below) _____ 13 Insecticide storage _____					
Direction from well? <u>South</u>		How many feet? <u>60</u>			
FROM	TO	LITHOLOGIC LOG		FROM	TO
0	80	Clay			
80	130	Sand and Gravel			
7 CONTRACTOR'S OR LANDOWNER'S CERTIFICATION: This water well was (1) <u>constructed</u> , (2) reconstructed, or (3) plugged under my jurisdiction and was completed on (mo/day/year) <u>1/5/84</u> and this record is true to the best of my knowledge and belief. Kansas Water Well Contractor's License No. <u>186</u> . This Water Well Record was completed on (mo/day/yr) <u>2/29/84</u> under the business name of <u>Kellys Water Well Service</u> by (signature) <u>[Signature]</u>					
INSTRUCTIONS: Use typewriter or ball point pen, PLEASE PRESS FIRMLY and PRINT clearly. Please fill in blanks, underline or circle the correct answers. Send top three copies to Kansas Department of Health and Environment, Division of Environment, Environmental Geology Section, Topeka, KS 66620. Send one to WATER WELL OWNER and retain one for your records.					