USE TYPEWRITER OR BALL POINT PEN-PRESS FIRMLY, PRINT CLEARLY.

WATER WELL RECORD
KSA 82a-1201-1215

Kansas Department of Health and Environment-Division of Environment
(Water well Contractors)
Topeka, Kansas 66620

1. Location of well:	County	Fraction	Section number	Township number	Range number
	Kingman	NW 1/4 NW 1/4 NW 1/4	35	X 28 S	R 8 (W)

2. Distance and direction from nearest town or city: 1 1/2 mi North 2 West of Cleveland Kns
Street address of well location if in city:

3. Owner of well: O.M. & Ruth Ramsey
R.R. or street:
City, state, zip code: 1026 Cedar - Kingman Kns - 67068

X Locate with "X" in section below:

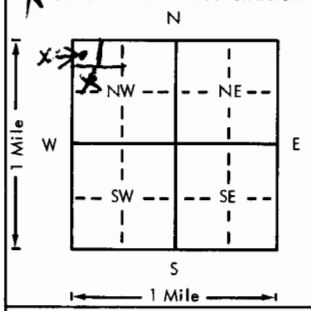

Sketch map:

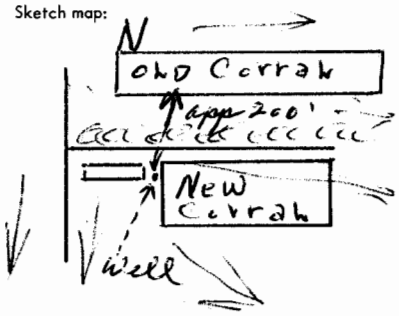

6. Bore hole dia. 9 1/4 in. Completion date Sept 12-78
Well depth 119 ft.

7. __ Cable tool X Rotary __ Driven __ Dug
__ Hollow rod __ Jetted __ Bored __ Reverse rotary

8. Use: __ Domestic __ Public supply __ Industry
__ Irrigation __ Air conditioning X Stock
__ Lawn __ Oil field water __ Other

9. Casing: Material PLTS Height: Above or below
Threaded ___ Welded ___ Surface 14 in.
RMP X PVC ___ Weight 2 lbs./ft.
Dia. 5" in. to 119 ft. depth Wall Thickness: inches or
Dia. 5" in. to 119 ft. depth gage No. 200 Wall

5. Type and color of material	From	To
top Soil (Blk)	0'	2'
Brn. Clay	2'	23'
Fine Sand	23'	37'
Brn Clay	37'	56'
Course Sand	56'	71'
White Clay	71'	79'
Course Sand	79'	119'
Red Bed.		

(Use a second sheet if needed)

10. Screen: Manufacturer's name J & D
Type R.M.P. Dia. 5"
Slot/gauze 1/8" Length 20'
Set between 119 ft. and 99 ft.
___ ft. and ___ ft.
Gravel pack? X Size range of material 1/8" x 3/8"

11. Static water level: mo./day/yr.
57 ft. below land surface X date Dec 9-78

12. Pumping level below land surfaces:
N/A ft. after ___ hrs. pumping ___ g.p.m.
___ ft. after ___ hrs. pumping ___ g.p.m.
Estimated maximum yield ___ g.p.m.

13. Water sample submitted: mo./day/yr.
__ Yes ✓ No Date ___

14. Well head completion:
X Pitless adapter 14 Inches above grade

15. Well grouted? ✓
With: ___ Neat cement ___ Bentonite X Concrete
Depth: From 4' ft. to 16' ft.

16. Nearest source of possible contamination:
ft. 200 Direction North Type Corrals
Well disinfected upon completion? X Yes ___ No

17. Pump: ___ Not installed
Manufacturer's name Sta-Rite
Model number 208 FC3-E HP 3/4 Volts 220
Length of drop pipe 100 ft. capacity 20 g.p.m.
Type:
X Submersible ___ Turbine
___ Jet ___ Reciprocating
___ Centrifugal ___ Other

T 28 S R 8 (W) Sec 35 NE 1/4 NW 1/4 NW 1/4

18. Elevation:
Topography:
___ Hill
X Slope
___ Upland
___ Valley

19. Remarks:

20. Water well contractor's certification:
This well was drilled under my jurisdiction and this report is true to the best of my knowledge and belief.
Wells Drilling Co 112
Business name License No.
Address 1030 Hwy 54 E. Kingman Kns
Signed Del Wells Date Dec 9-78
Authorized representative

Forward the white, blue and pink copies to the Department of Health and Environment

Form WWC-5